

STA 17+375 RT
STOP TEMPORARY
WIDENING FOR
PHASE I TRAFFIC

STA 17+394 RT
RESUME TEMPORARY
WIDENING FOR
PHASE I TRAFFIC


STA 17+411 RT
RESUME TEMPORARY
WIDENING FOR
PHASE I TRAFFIC

STA 17+461 RT
STOP TEMPORARY
WIDENING FOR
PHASE I TRAFFIC

STA 17+405 RT
STOP TEMPORARY
WIDENING FOR
PHASE I TRAFFIC

STA 17+473 RT
RESUME TEMPORARY
WIDENING FOR
PHASE I TRAFFIC

STA 17+487 RT
STOP TEMPORARY
WIDENING FOR
PHASE I TRAFFIC

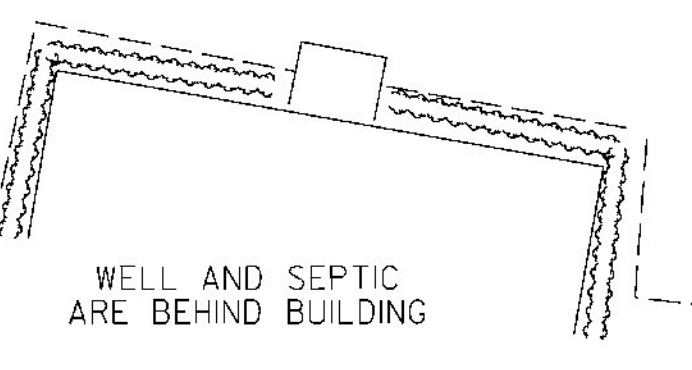

WELL IS NORTH OF BUILDING
SEPTIC IS BEHIND BUILDING

LEGEND	
	PHASE I CONSTRUCTION
	TEMPORARY WIDENING FOR PHASE I TRAFFIC
	TEMPORARY WIDENING FOR PHASE II TRAFFIC
	PHASE I TRAFFIC
	SSL SINGLE SOLID WHITE LINE 100mm WIDE (PAINT)
	DSL DOUBLE SOLID YELLOW LINE 100mm WIDE (PAINT)



PHASE I
TRAFFIC CONTROL PLAN 7

PROJECT NAME: BRANDON	PLOT DATE: 9/3/2009
PROJECT NUMBER: NH 019-3(495)	DRAWN BY: NLL
FILE NAME: zb008s5+cp07.dgn	CHECKED BY: KLS
PROJECT LEADER: CRB	SHEET 288 OF 546
DESIGNED BY: PTS	
CLD 02-0149	