


STA 17+720 RT
STOP TEMPORARY WIDENING
FOR PHASE II TRAFFIC

| LEGEND | |
|--------|--|
| | PHASE I CONSTRUCTION |
| | TEMPORARY WIDENING FOR PHASE I TRAFFIC |
| | TEMPORARY WIDENING FOR PHASE II TRAFFIC |
| | PHASE I TRAFFIC |
| SSL | SINGLE SOLID WHITE LINE 100mm WIDE (PAINT) |
| DSL | DOUBLE SOLID YELLOW LINE 100mm WIDE (PAINT) |

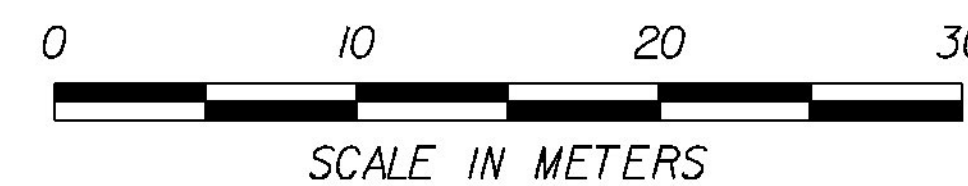

PHASE I
TRAFFIC CONTROL PLAN 9

| | | | |
|-----------------|-------------------|-------------|------------|
| PROJECT NAME: | BRANDON | PLOT DATE: | 9/3/2009 |
| PROJECT NUMBER: | NH 019-3(495) | DRAWN BY: | NLL |
| FILE NAME: | zb008s5-+cp09.dgn | CHECKED BY: | KLS |
| PROJECT LEADER: | CRB | SHEET | 290 OF 546 |
| DESIGNED BY: | PTS | | |
| CLD 02-0149 | | | |