




STA 16+418.474 BK
BEGIN APPROACH

STA 16+460.000 AHD
END APPROACH
BEGIN PROJECT
NH 019-3(495)

BEGIN PHASE II CONSTRUCTION
PHASED CONSTRUCTION WITH
TWO-WAY TRAFFIC

MATCH LINE STA 16+530

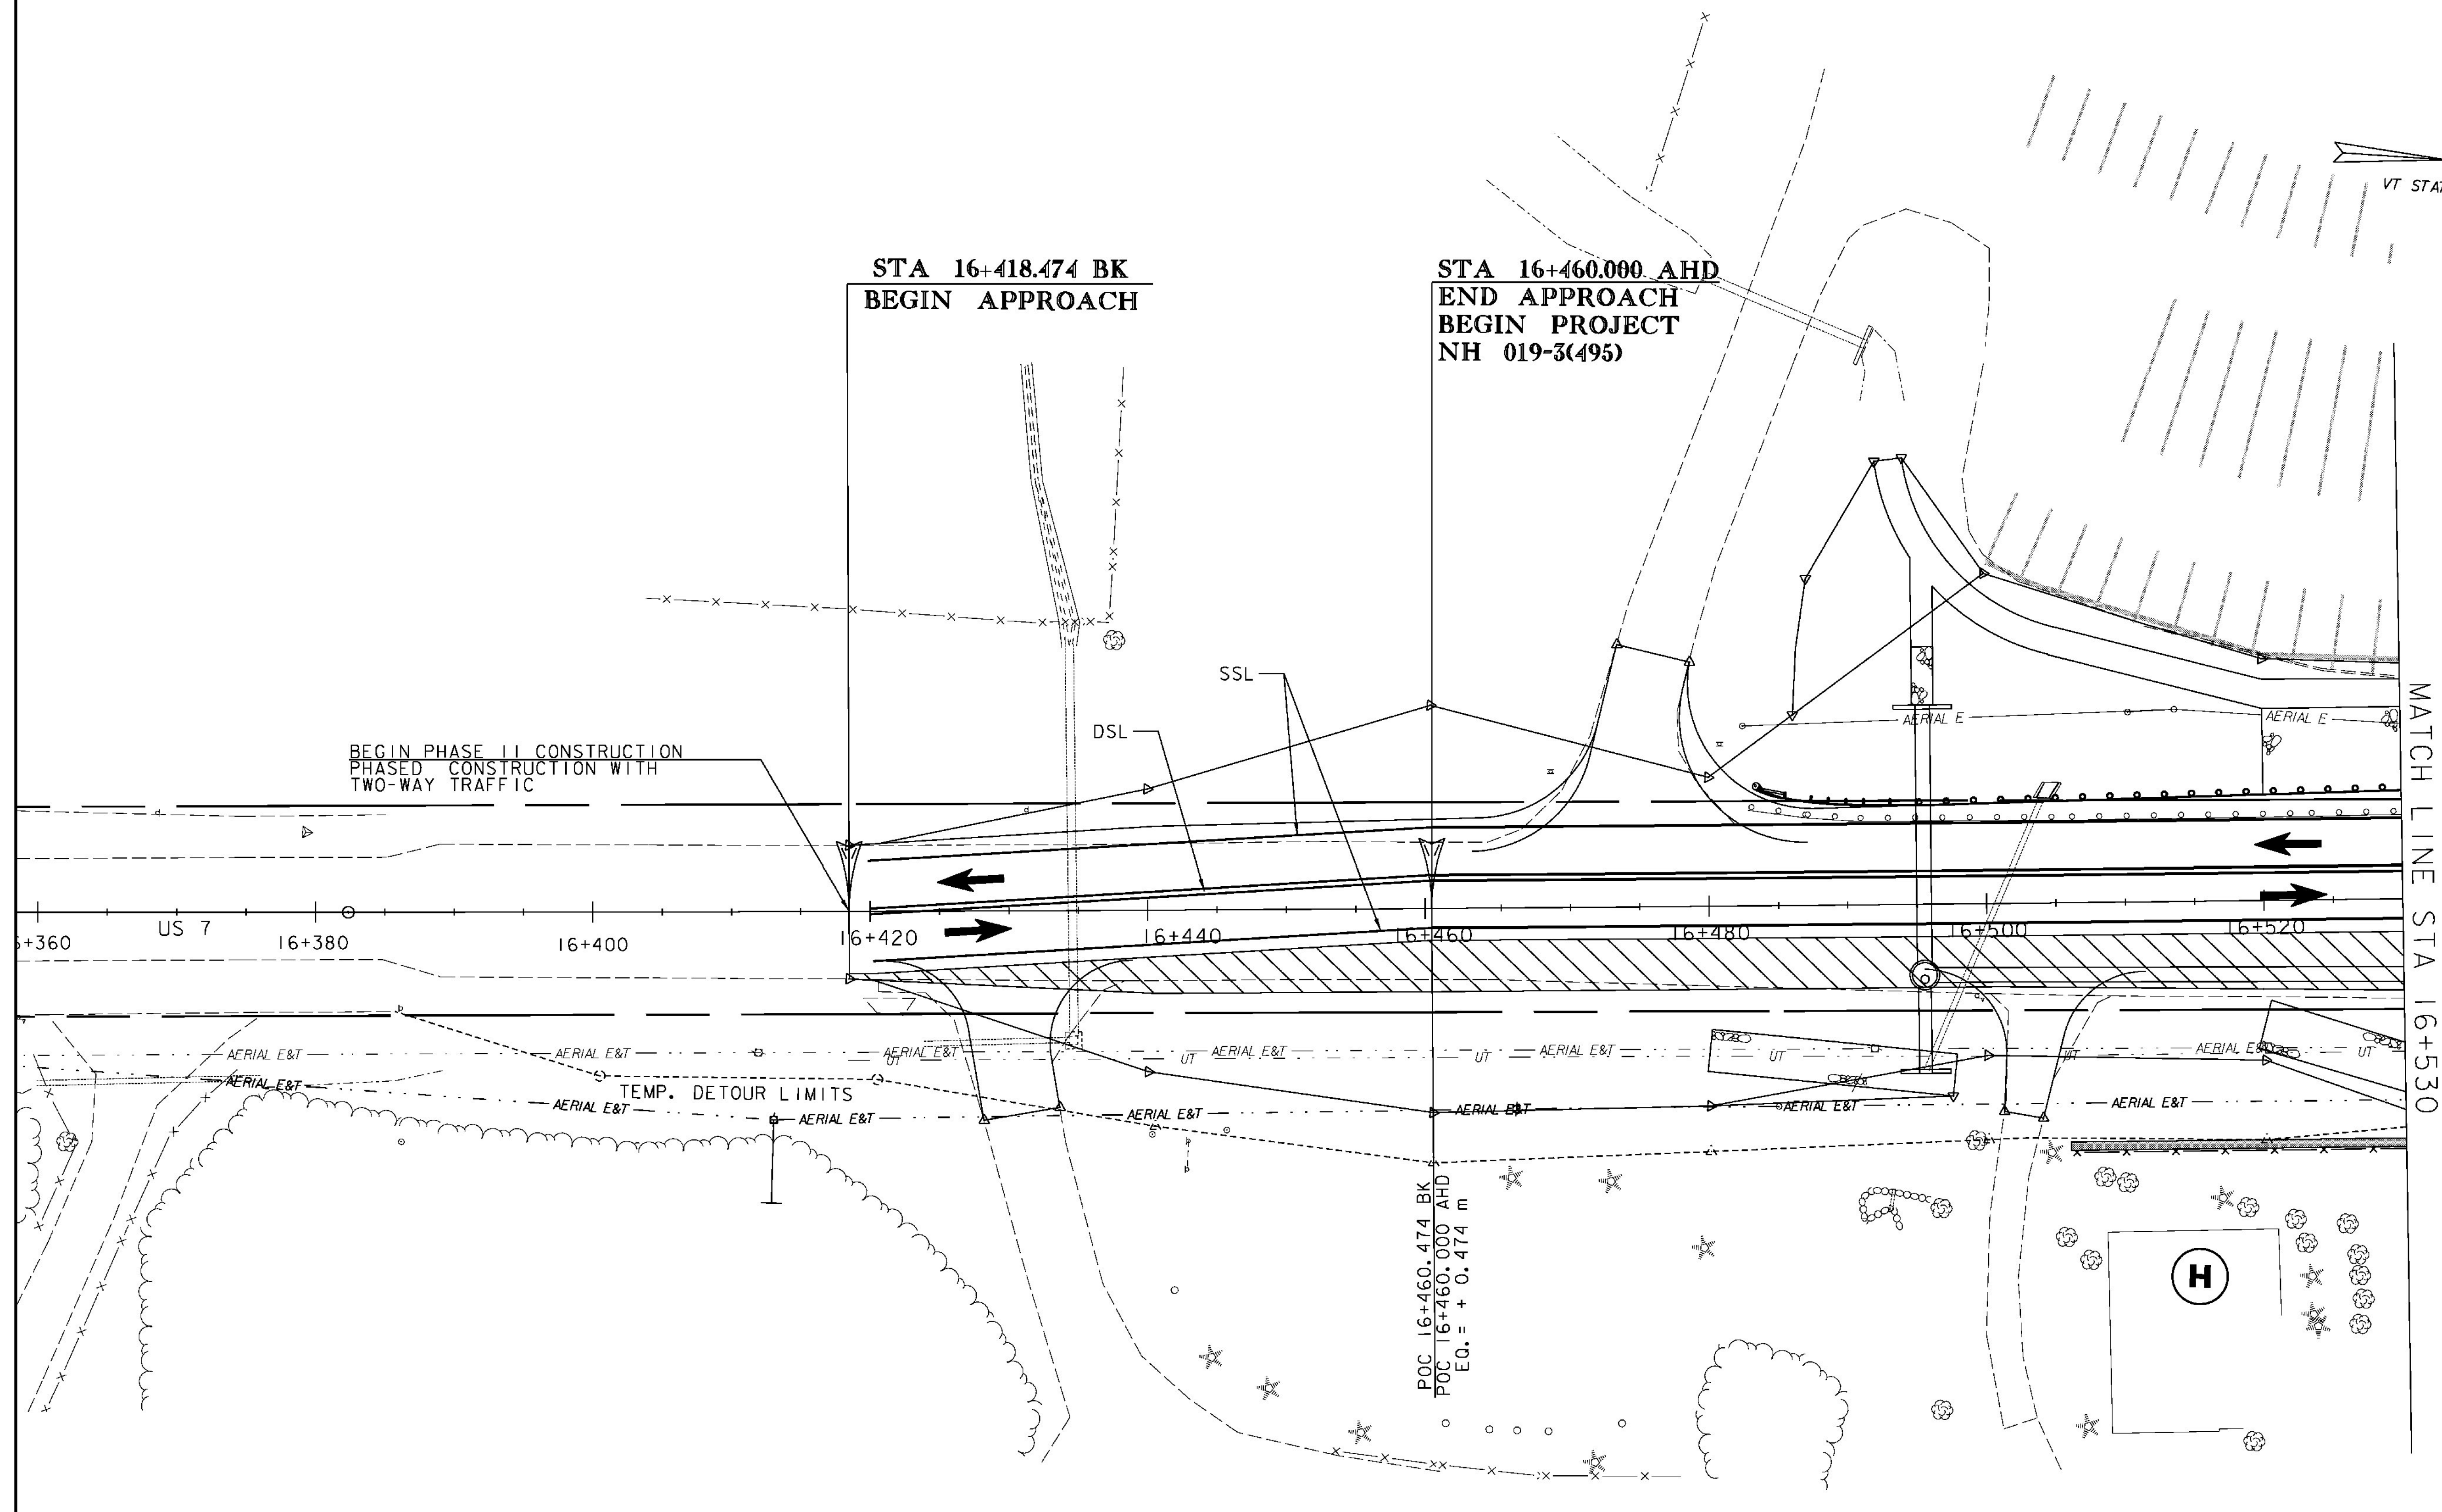

LEGEND	
	PHASE II CONSTRUCTION
	PHASE II TRAFFIC
	SSL SINGLE SOLID WHITE LINE 100mm WIDE (TYPE II TAPE)
	DSL DOUBLE SOLID YELLOW LINE 100mm WIDE (TYPE II TAPE)



PHASE II
TRAFFIC CONTROL PLAN I

PROJECT NAME:	BRANDON	PLOT DATE:	9/3/2009
PROJECT NUMBER:	NH 019-3(495)	DRAWN BY:	NLL
FILE NAME:	zb008s5+cp29.dgn	CHECKED BY:	KLS
PROJECT LEADER:	CRB	CLD 02-0149	SHEET 310 OF 546
DESIGNED BY:	PTS		