


MATCH LINE STA 16+690

MATCH LINE STA 16+850

STA 16+800  
STOP PHASED CONSTRUCTION  
WITH TWO-WAY TRAFFIC

STA 16+800  
BEGIN ALTERNATING ONE-WAY  
TRAFFIC FOR CROSSOVER  
SEE STD. E-110

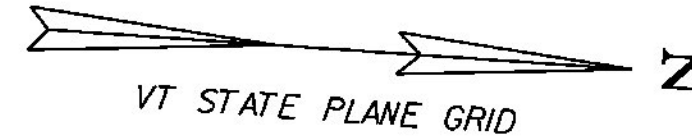

(ARTESIAN WELL - SOUTH OF SCHOOL)  
(SEWER TREATMENT PLANT - WEST OF SCHOOL)

WETLAND  
CLASS 3

HAWK VIEW  
RD  
T.H. 86

LEGEND	
	PHASE II CONSTRUCTION
	PHASE II TRAFFIC
	SSL SINGLE SOLID WHITE LINE 100mm WIDE (TYPE II TAPE)
	DSL DOUBLE SOLID YELLOW LINE 100mm WIDE (TYPE II TAPE)



PHASE II  
TRAFFIC CONTROL PLAN 3

PROJECT NAME: BRANDON	PLOT DATE: 9/3/2009
PROJECT NUMBER: NH 019-3(495)	DRAWN BY: NLL
FILE NAME: zb008s5+tcp3l.dgn	CHECKED BY: KLS
PROJECT LEADER: CRB	SHEET 312 OF 546
DESIGNED BY: PTS	
CLD 02-0149	