


18+600.0

TRAFFIC CONTROL CROSS SECTIONS
PHASE I, PHASE II AND PHASE III

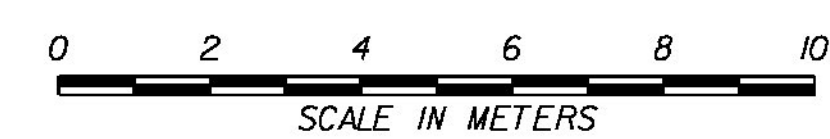

PROJECT NAME:	BRANDON	PLOT DATE:	9/3/2009
PROJECT NUMBER:	NH 019-3(495)	DRAWN BY:	NLL
FILE NAME:	zb008s5-+cpxs077.dgn	CHECKED BY:	KLS
PROJECT LEADER:	CRB	SHEET	363 OF 546
DESIGNED BY:	PTS		
CLD 02-0149			