


19+200.0

TRAFFIC CONTROL CROSS SECTIONS
PHASE I AND PHASE II

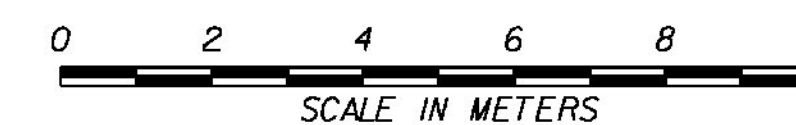

| | | | |
|-----------------|----------------------|-------------|------------|
| PROJECT NAME: | BRANDON | PLOT DATE: | 9/3/2009 |
| PROJECT NUMBER: | NH 019-3(495) | DRAWN BY: | NLL |
| FILE NAME: | zb008s5-+cpxs202.dgn | CHECKED BY: | KLS |
| PROJECT LEADER: | CRB | SHEET | 367 OF 546 |
| DESIGNED BY: | PTS | | |
| CLD 02-0149 | | | |