


20+500.0

TRAFFIC CONTROL CROSS SECTIONS
PHASE I AND PHASE II

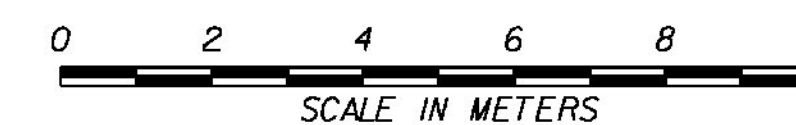

PROJECT NAME:	BRANDON	PLOT DATE:	9/3/2009
PROJECT NUMBER:	NH 019-3(495)	DRAWN BY:	NLL
FILE NAME:	zb008s5-+cpxs259.dgn	CHECKED BY:	KLS
PROJECT LEADER:	CRB	SHEET	380 OF 546
DESIGNED BY:	PTS		
CLD 02-0149			