



DETAIL "A"

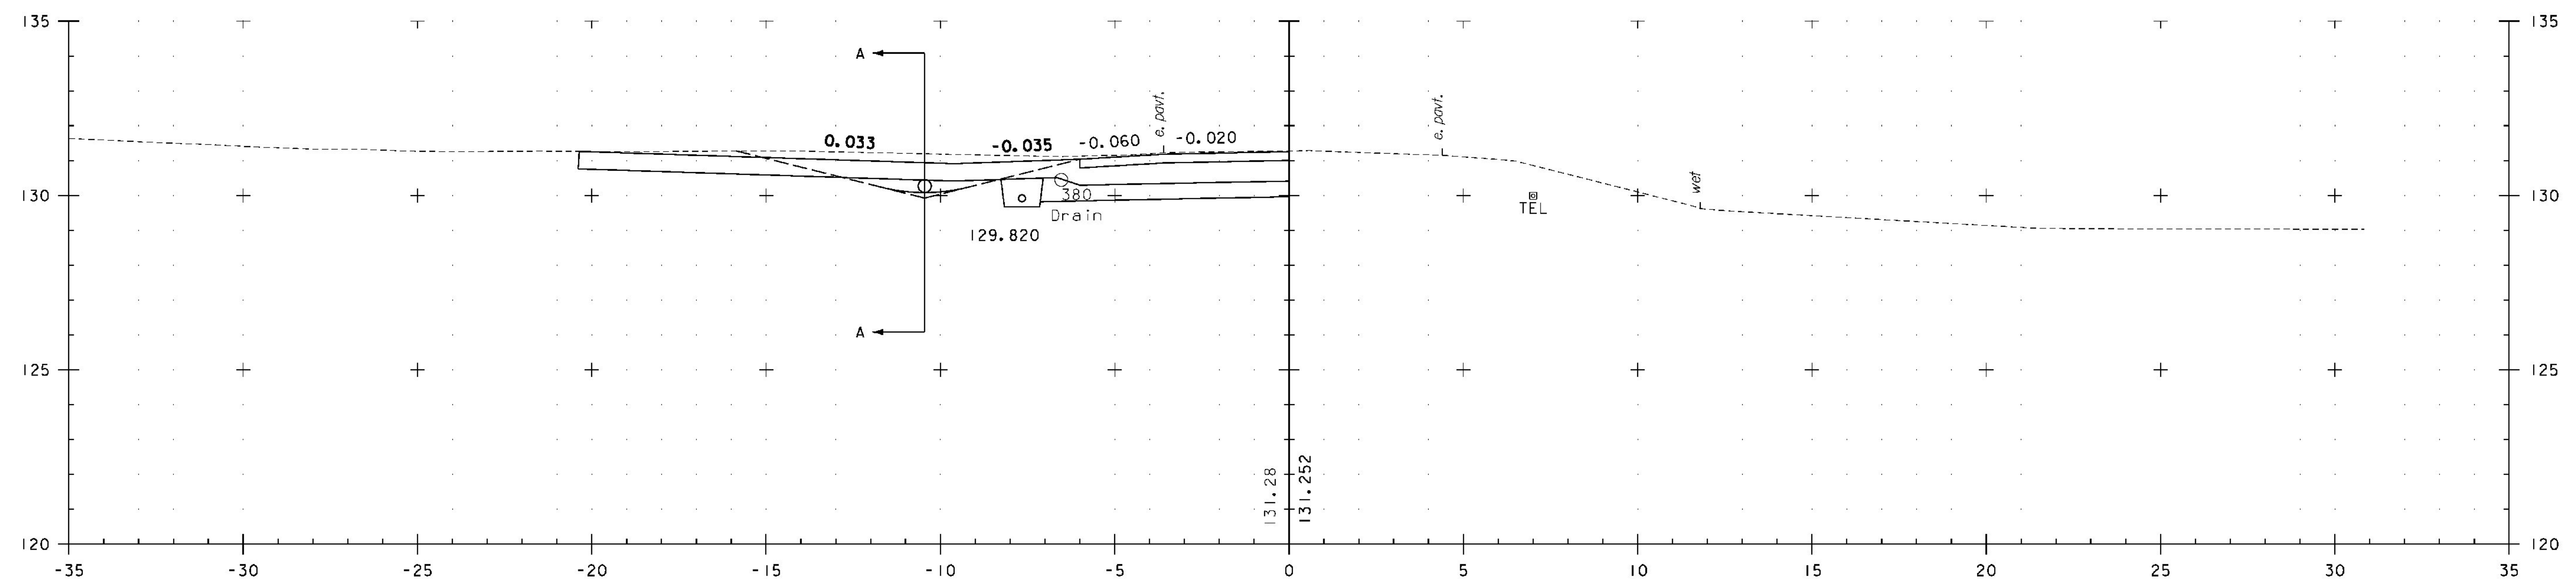

18+164.0  
DRIVE LT

US 7

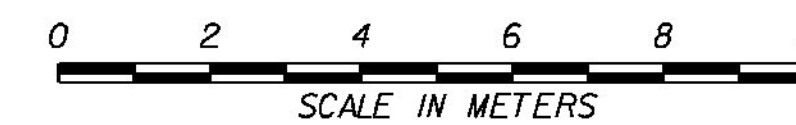

PROJECT NAME:	BRANDON	PLOT DATE:	9/3/2009
PROJECT NUMBER:	NH 019-3(495)	DRAWN BY:	NLL
FILE NAME:	zb008s5-xs062.dgn	CHECKED BY:	DAM
PROJECT LEADER:	CRB	SHEET	443 OF 546
DESIGNED BY:	PTS		
CLD 02-0149			