


19+940.0

US 7

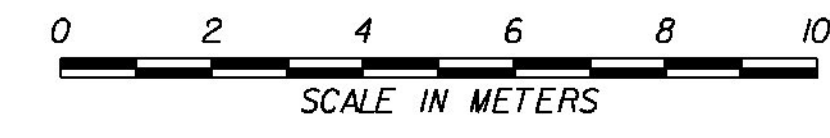

|                 |                   |             |            |
|-----------------|-------------------|-------------|------------|
| PROJECT NAME:   | BRANDON           | PLOT DATE:  | 9/3/2009   |
| PROJECT NUMBER: | NH 019-3(495)     | DRAWN BY:   | NLL        |
| FILE NAME:      | zb008s5-xs228.dgn | CHECKED BY: | DAM        |
| PROJECT LEADER: | CRB               | SHEET       | 499 OF 546 |
| DESIGNED BY:    | PTS               |             |            |
| CLD 02-0149     |                   |             |            |