




2+032.0
DRIVE RT

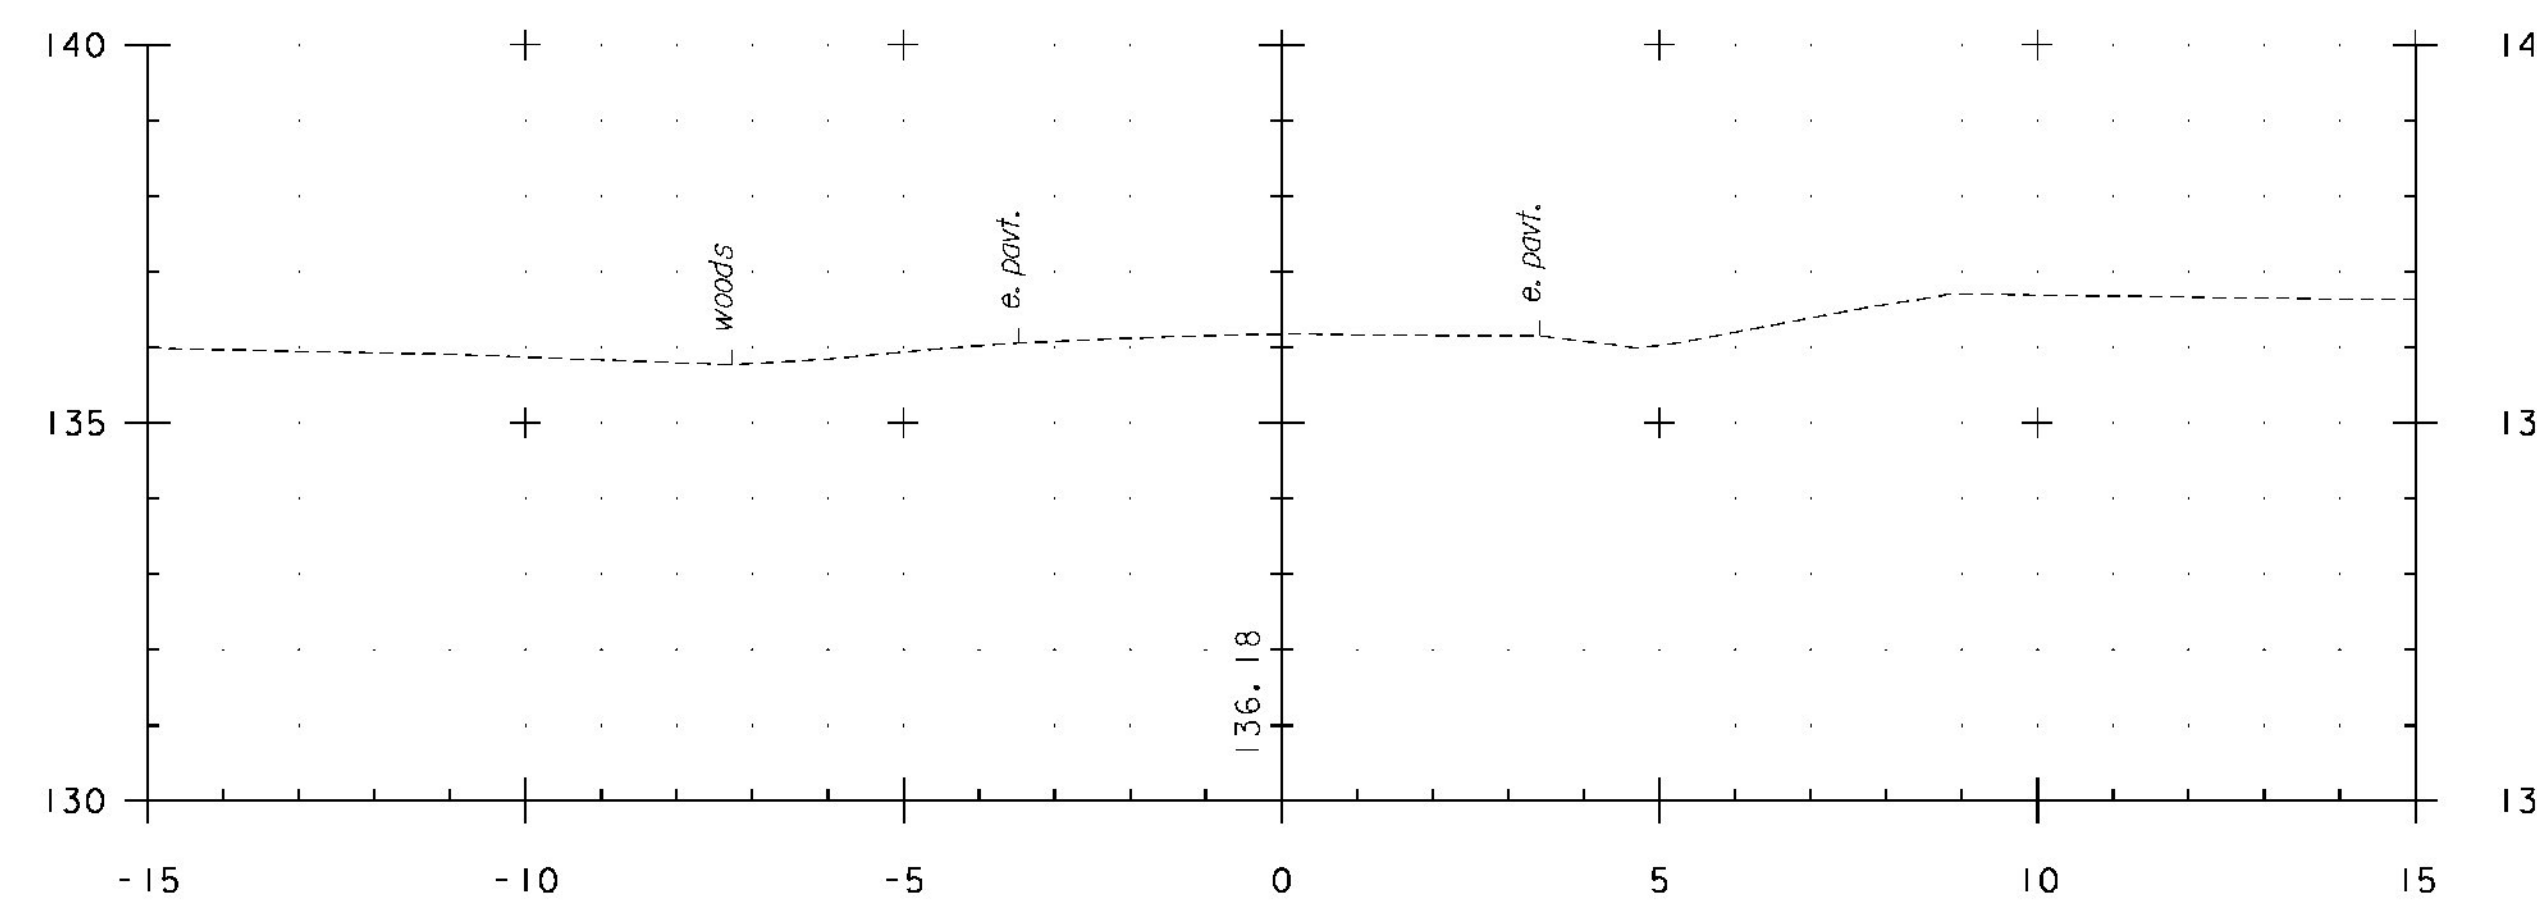


2+060.0

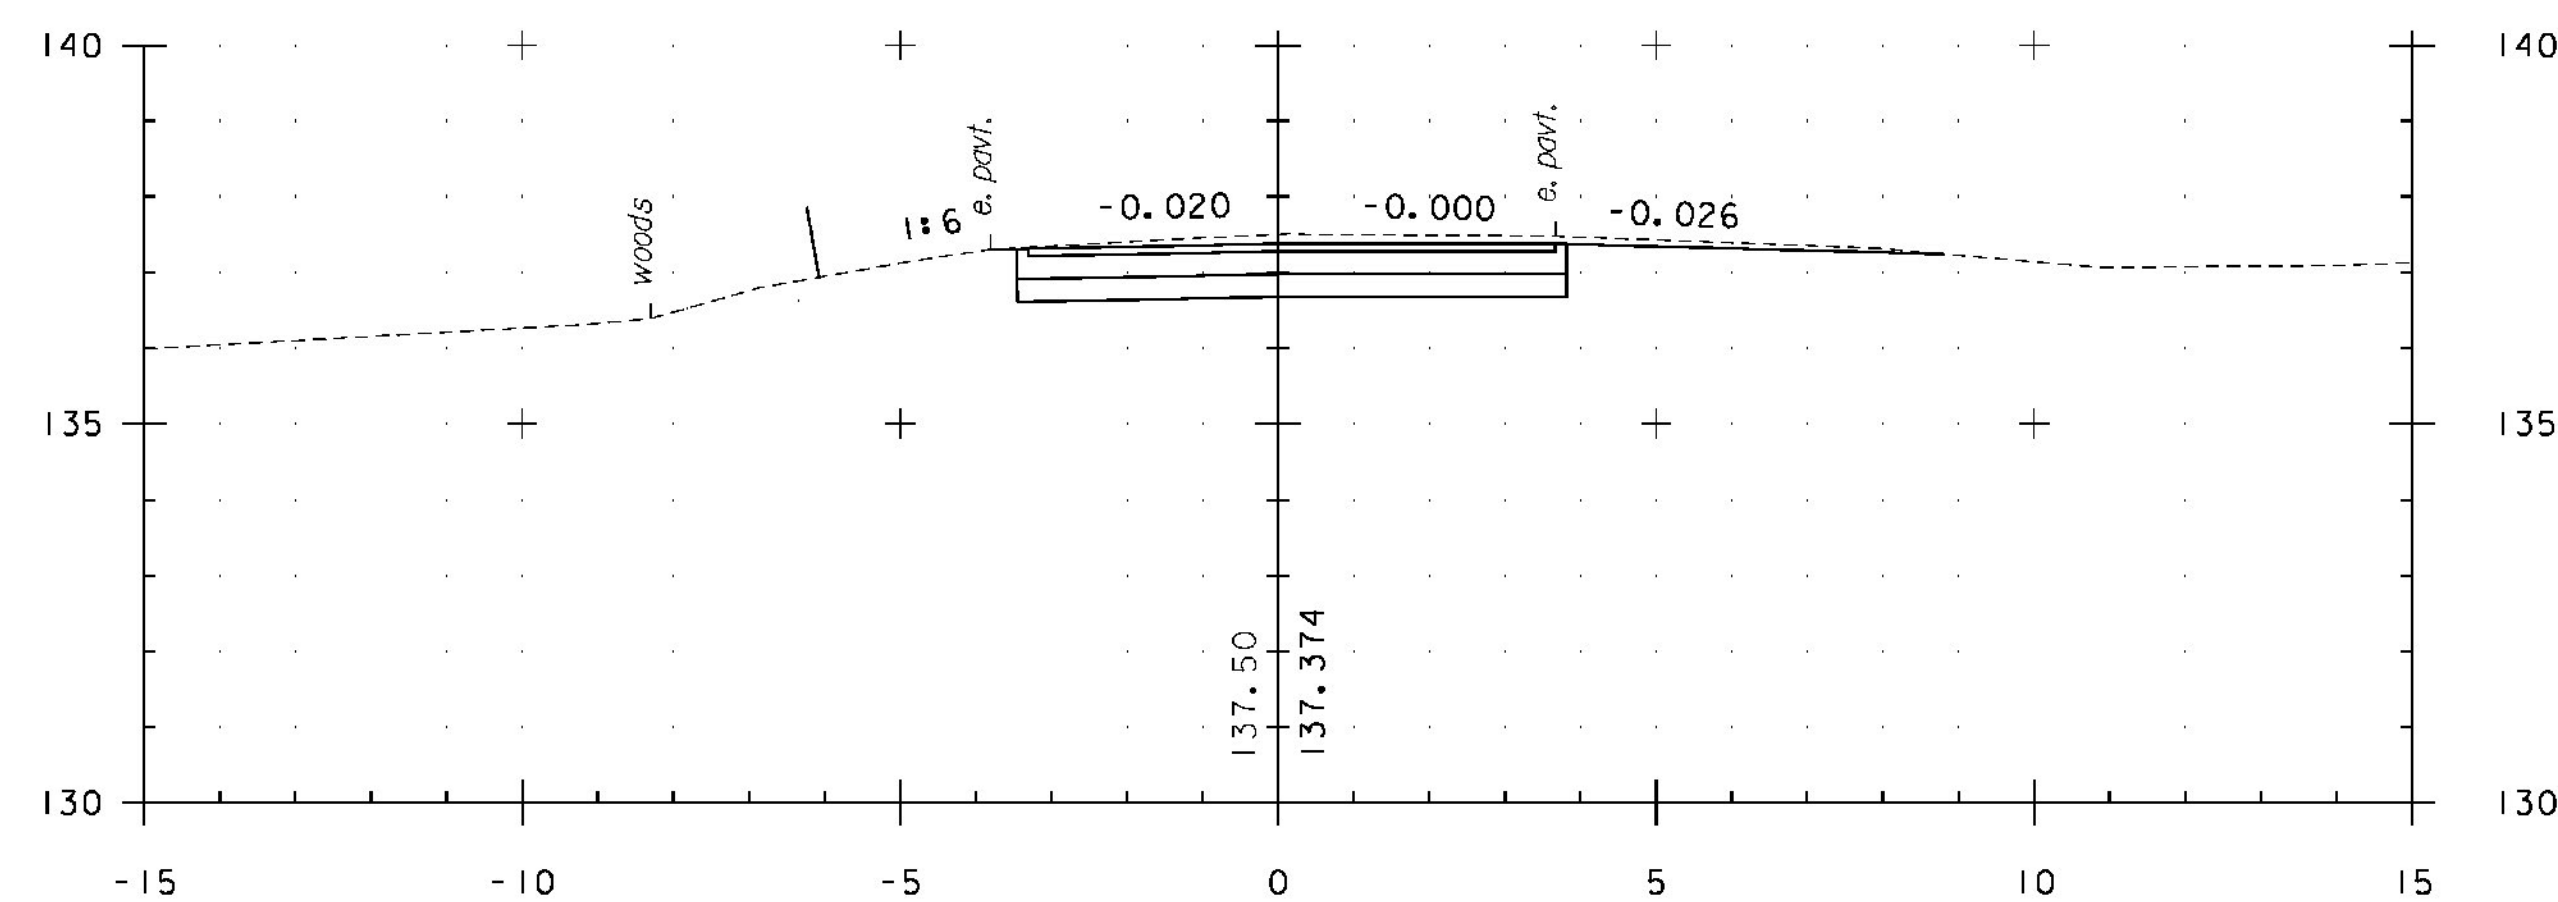

2+020.0

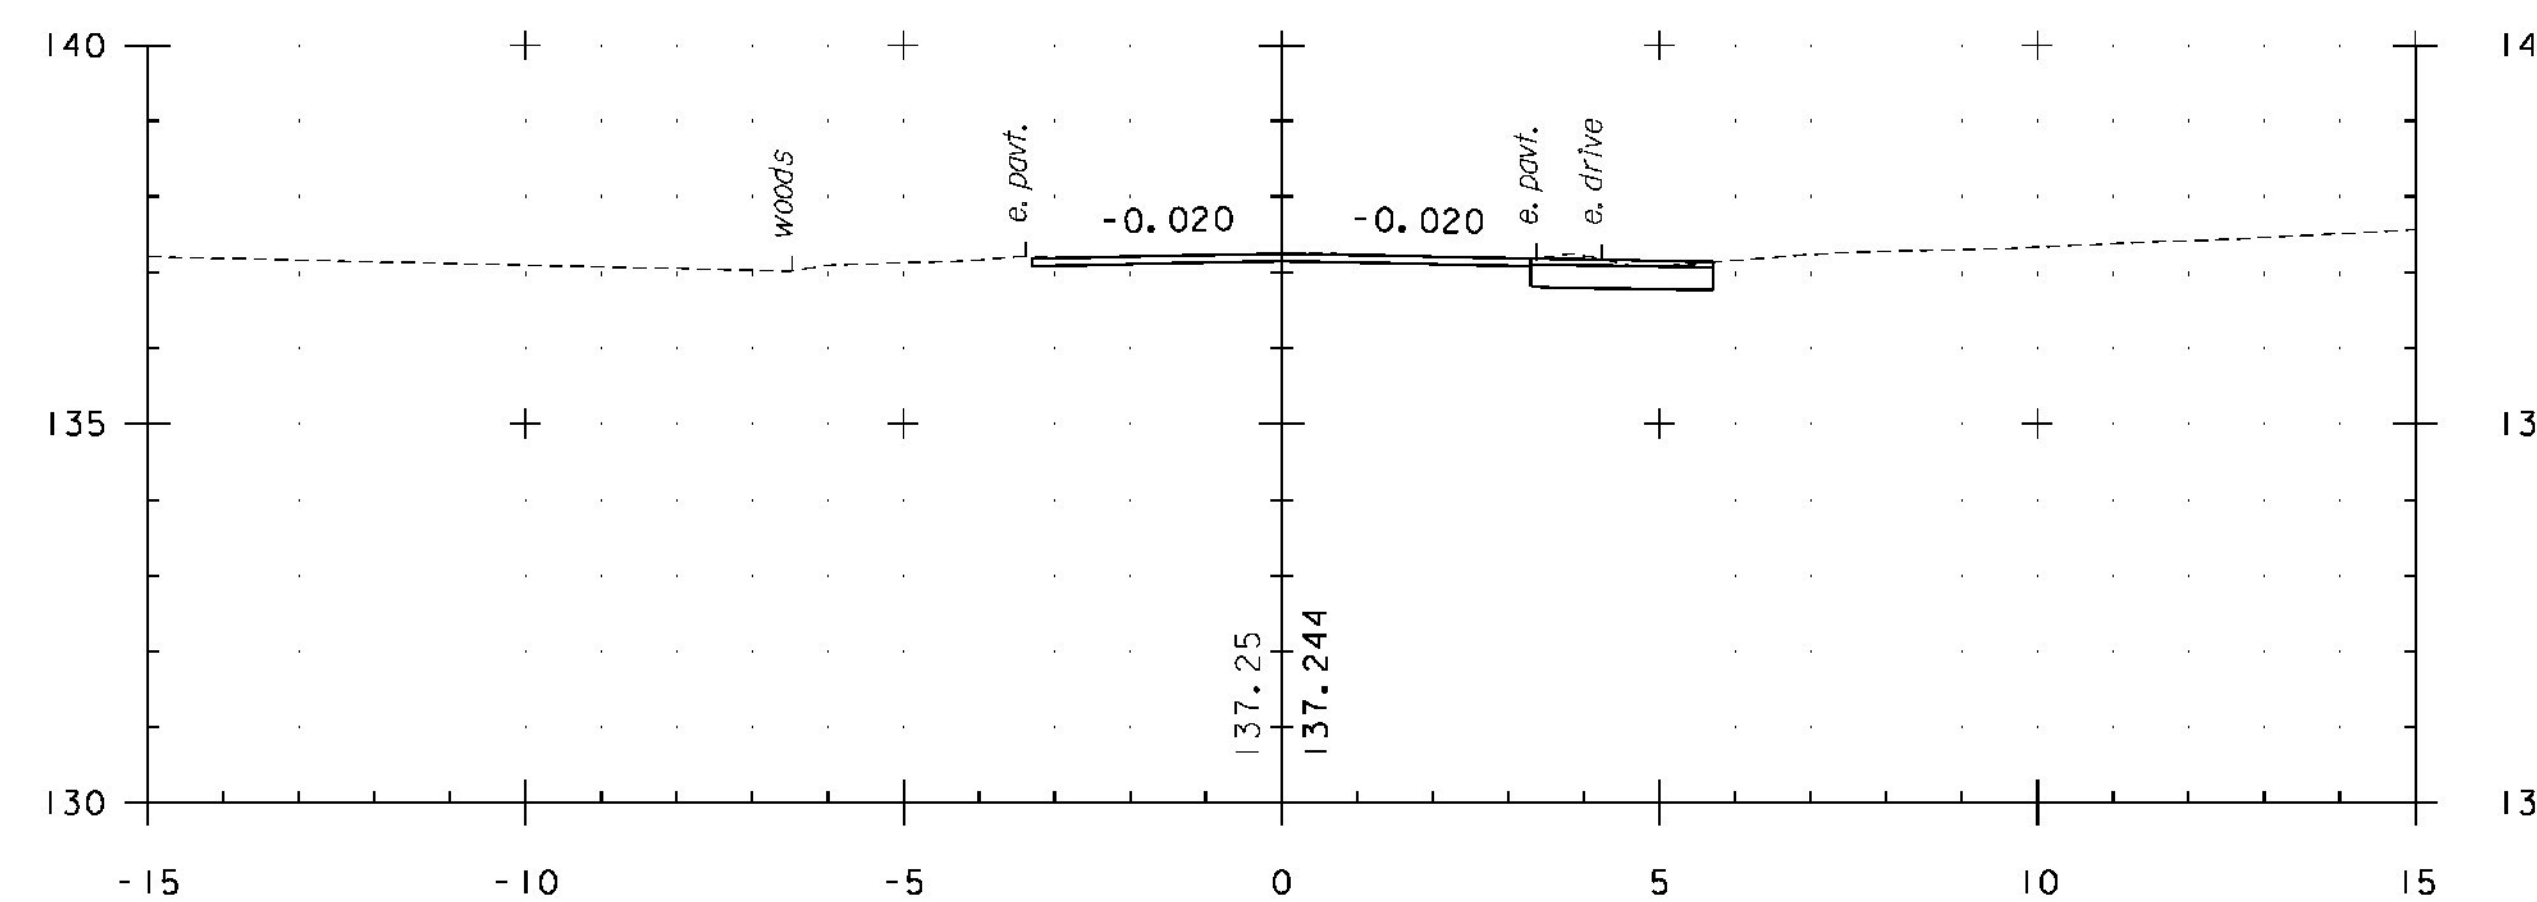

2+040.0

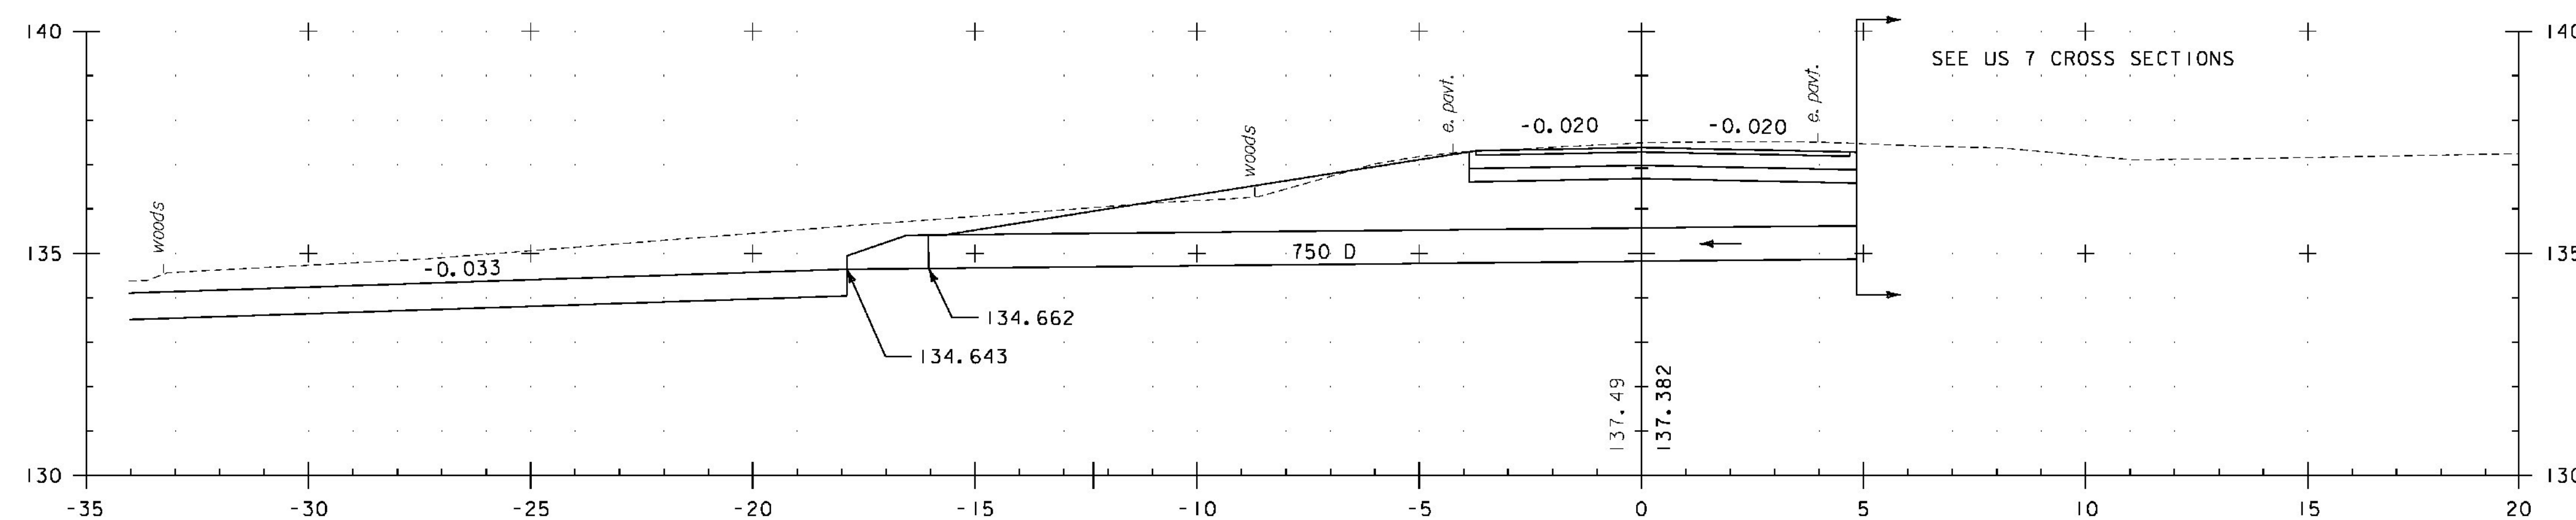

2+016.9 ASKEW 83°



NICKERSON ROAD

PROJECT NAME: BRANDON
 PROJECT NUMBER: NH 019-3(495)
 FILE NAME: zb008s5-xs400.dgn
 PROJECT LEADER: CRB
 DESIGNED BY: PTS
 CLD 02-0149

PLOT DATE: 9/3/2009
 DRAWN BY: NLL
 CHECKED BY: DAM
 SHEET 546 OF 546