


16+475.0
DRIVE LT



POC 16+460.474 BK
POC 16+460.000 AHD
EQ. = +0.474 m

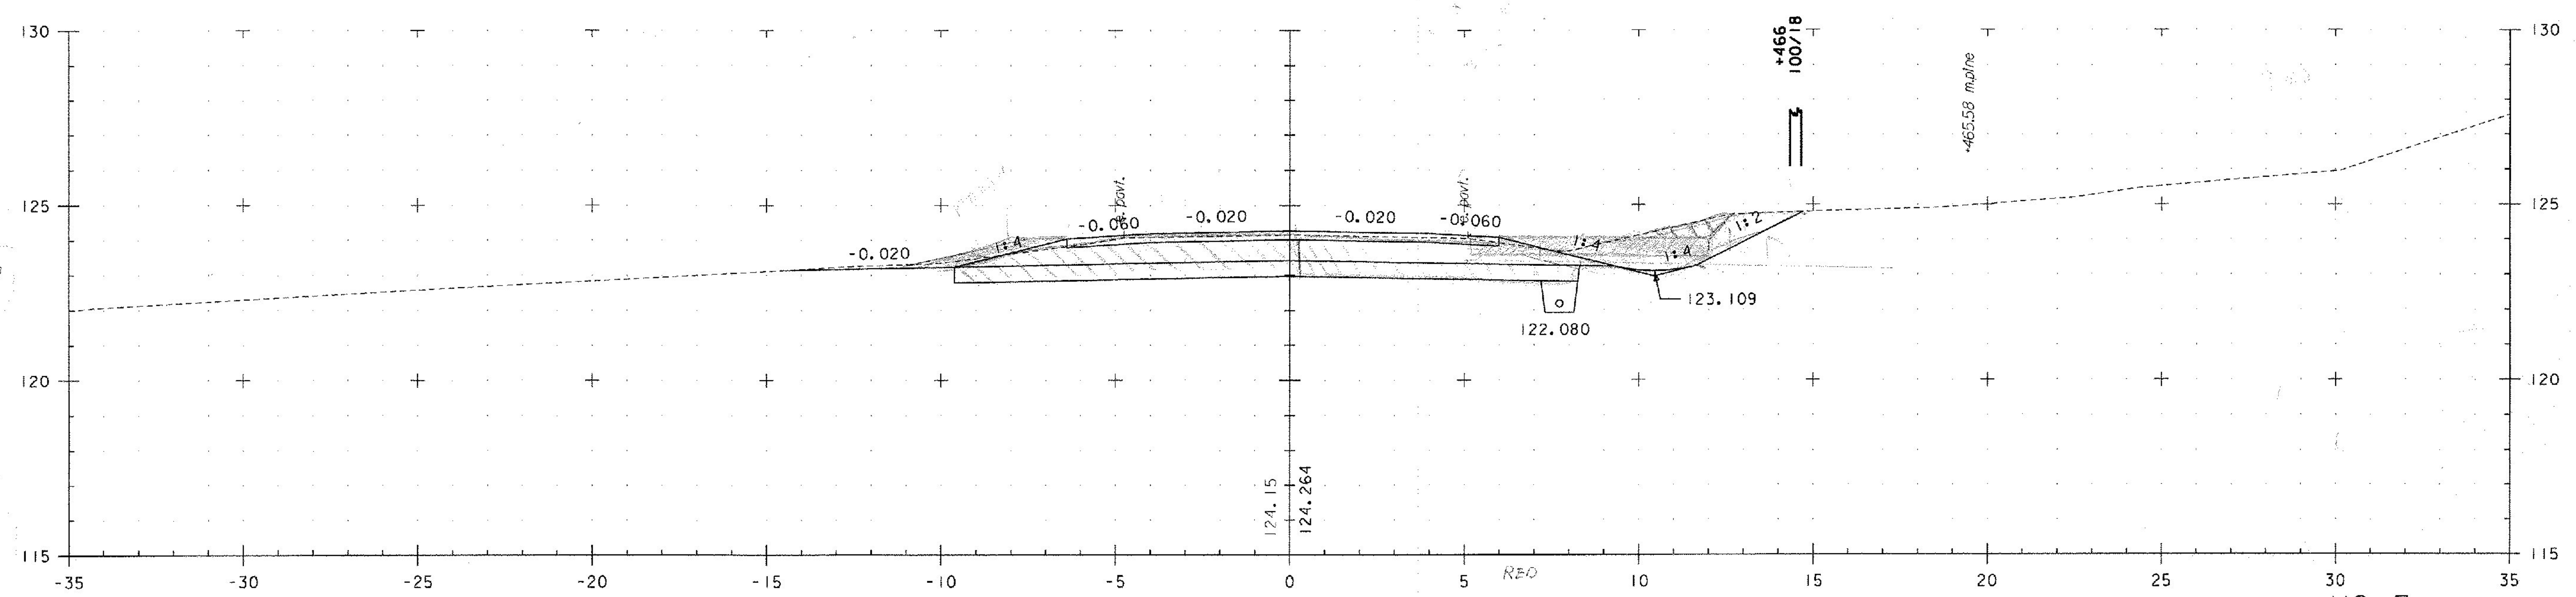

PROJECT NAME: BRANDON	FILE NAME: zb008s5-xs005.dgn	PLOT DATE: 9/3/2009
PROJECT NUMBER: NH 019-3(495)	PROJECT LEADER: CRB	DRAWN BY: NLL
	DESIGNED BY: PTS	CHECKED BY: DAM
	CLD 02-0149	SHEET 386 OF 546

19-1160
RW LT 9.58
R. PHS DEGR 1.25
RW RT 12.63
DESIGN 1.64
R PHS DEGR 1.9

45 x 54 x 49 = 111cm
.011 Per grade
.22 Per Slope

Handwritten notes and sketches in the upper right quadrant, including a small diagram of a structure and various numerical values like 7908 and 9.042.

11
18 x 14 x 27

Handwritten notes at the bottom center, including '110 = 6.0', '6.03 = 7.8', and '6.0 = 10.0'.