



16+660.0  
DRIVE LT

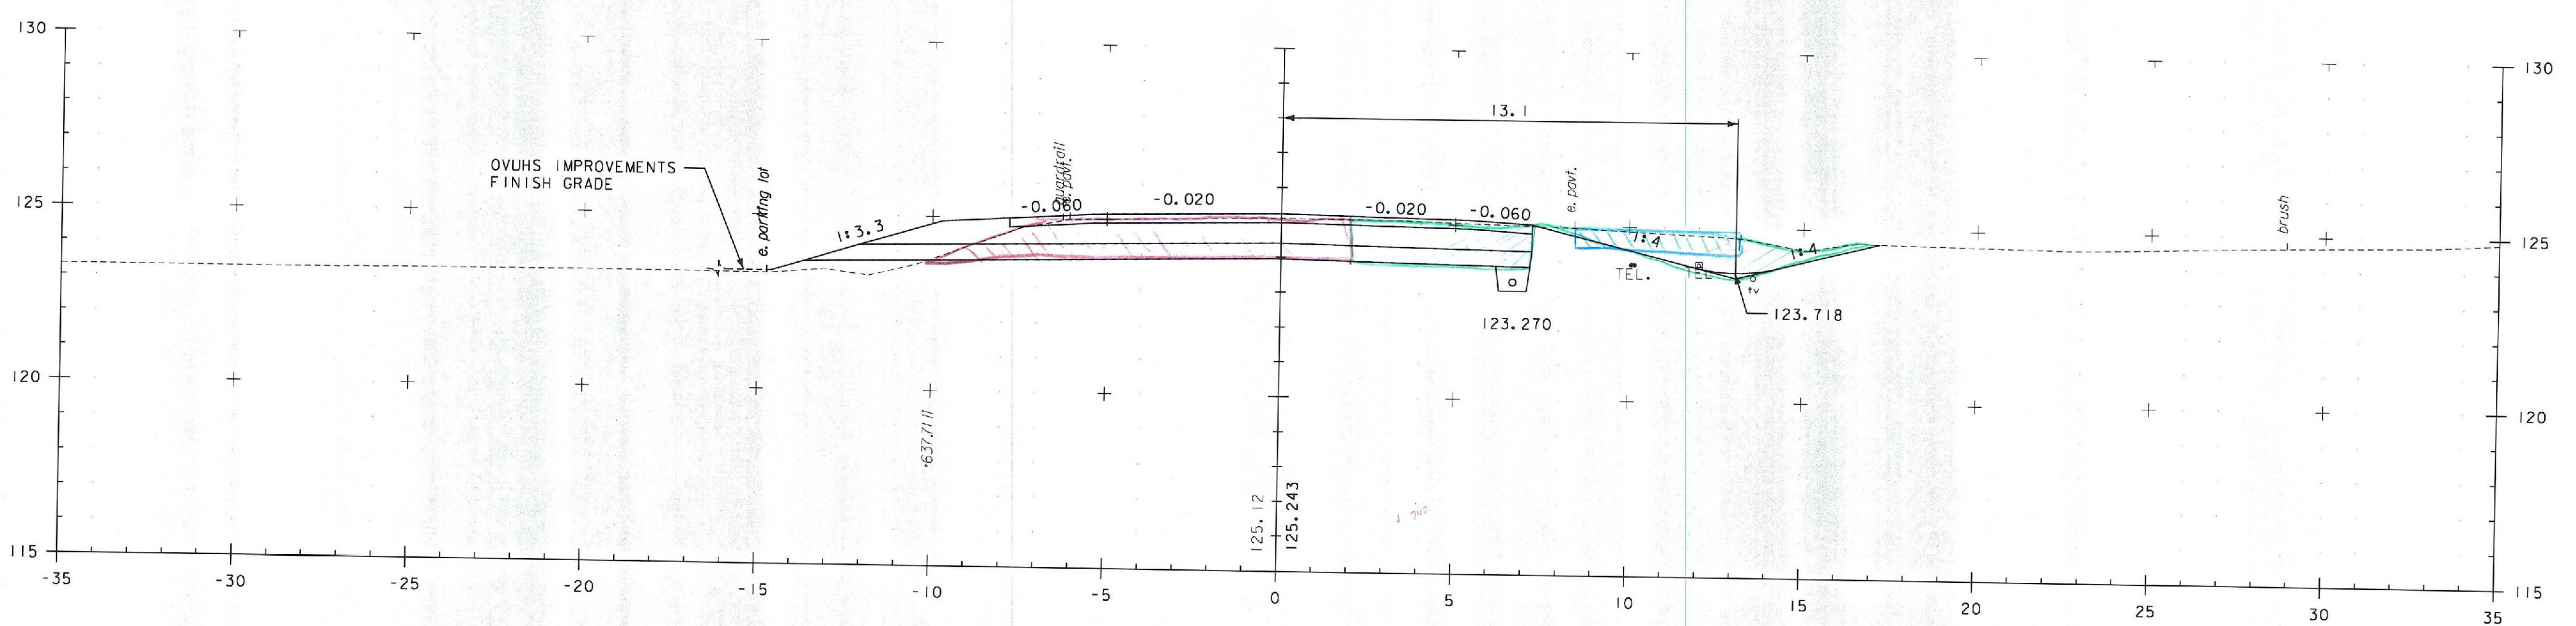

16+640.0  
US 7

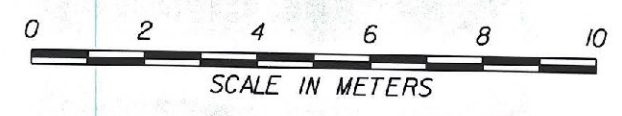

PROJECT NAME:	BRANDON	PLOT DATE:	9/3/2009
PROJECT NUMBER:	NH 019-3(495)	DRAWN BY:	NLL
FILE NAME:	zbd008e5-xs012.dgn	CHECKED BY:	DAM
PROJECT LEADER:	CRB	SHEET	393 OF 546
DESIGNED BY:	PTS		
CLD	02-0149		