



132 x .55 x 6.5

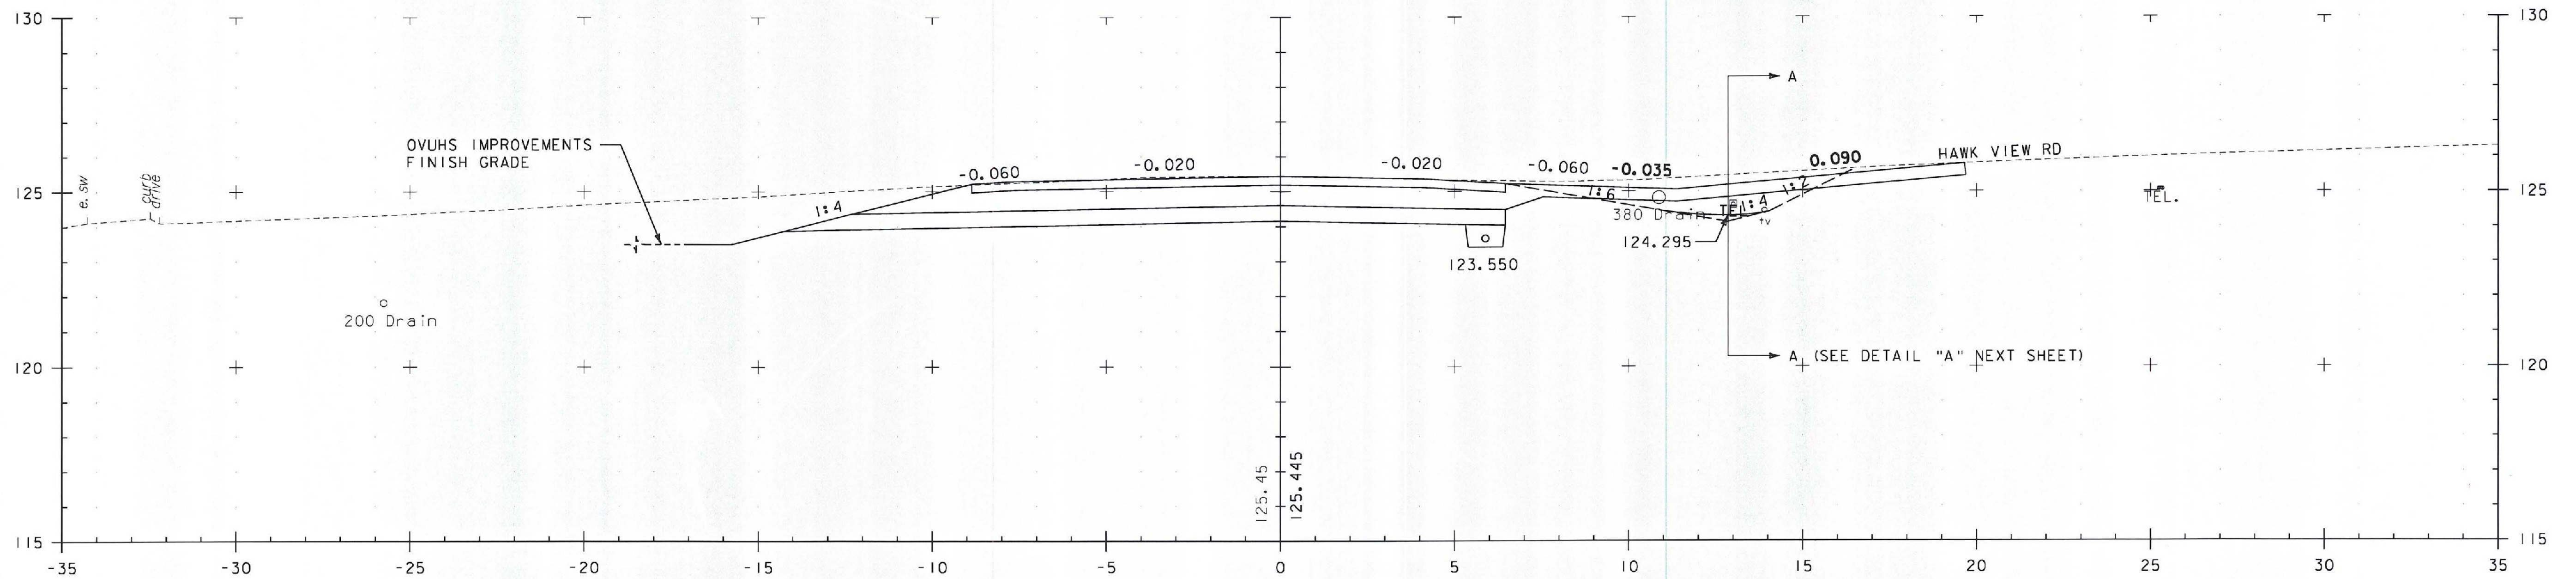


16+730.0
DRIVE RT

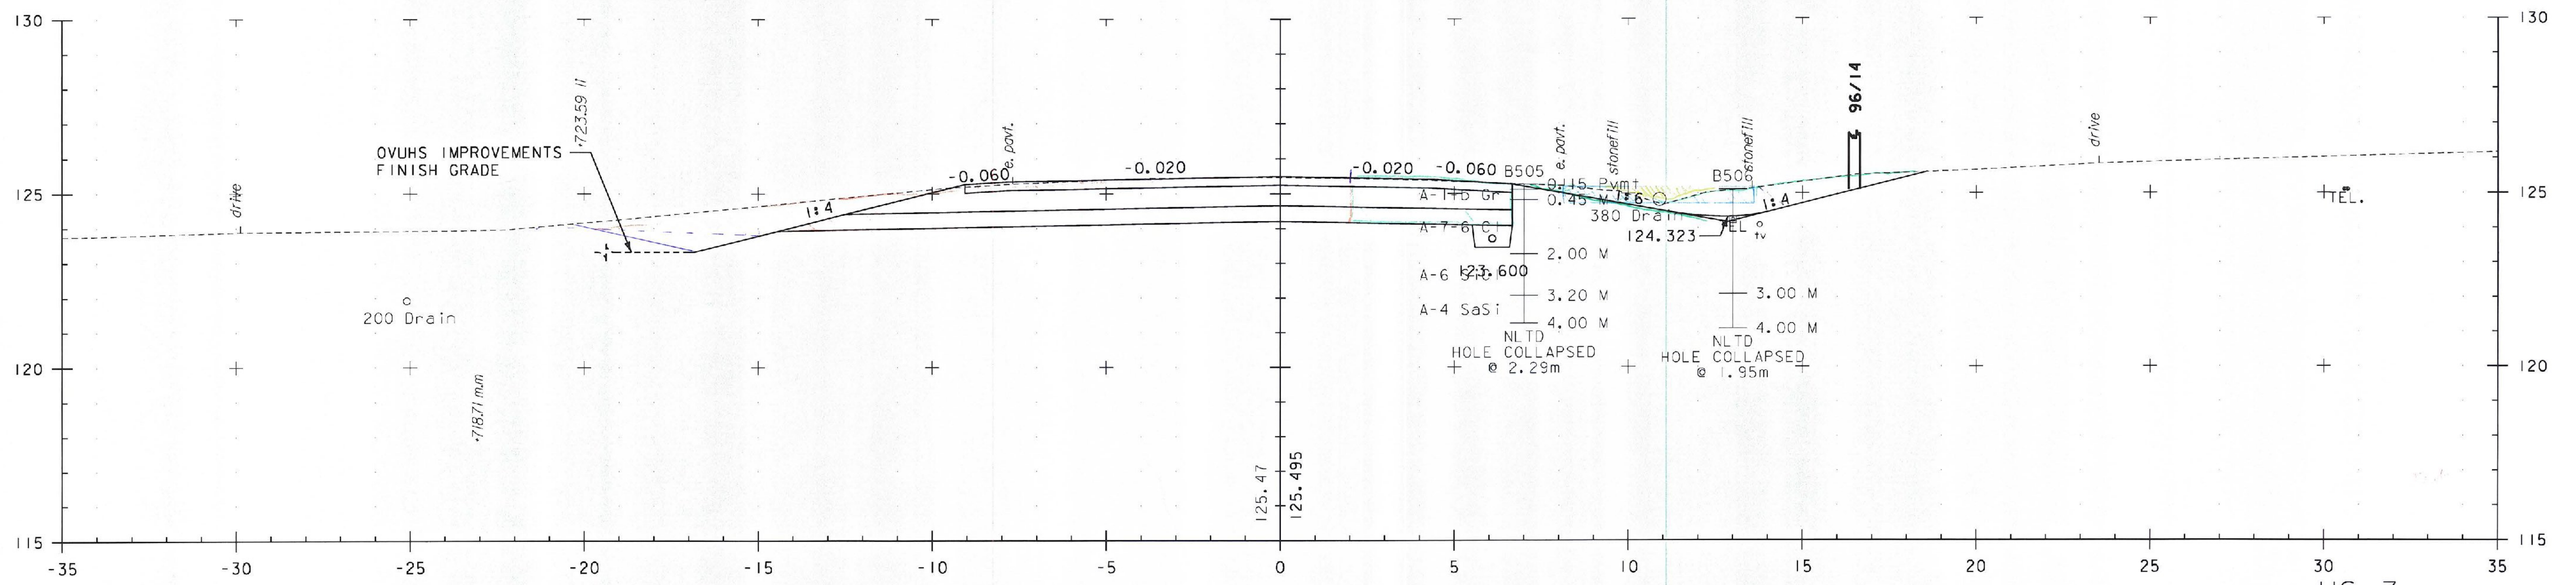

16+720.0

US 7

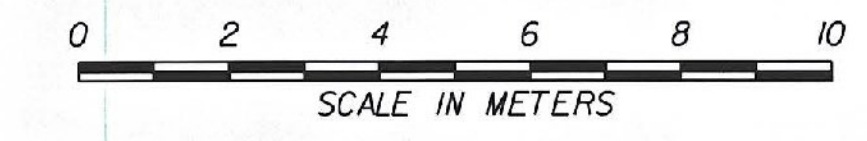

PROJECT NAME: BRANDON	PLOT DATE: 9/3/2009
PROJECT NUMBER: NH 019-3(495)	DRAWN BY: NLL
FILE NAME: zb008s5-xs014.dgn	CHECKED BY: DAM
PROJECT LEADER: CRB	SHEET 395 OF 546
DESIGNED BY: PTS	
CLD 02-0149	