



16+904.0
ASKEW 100°

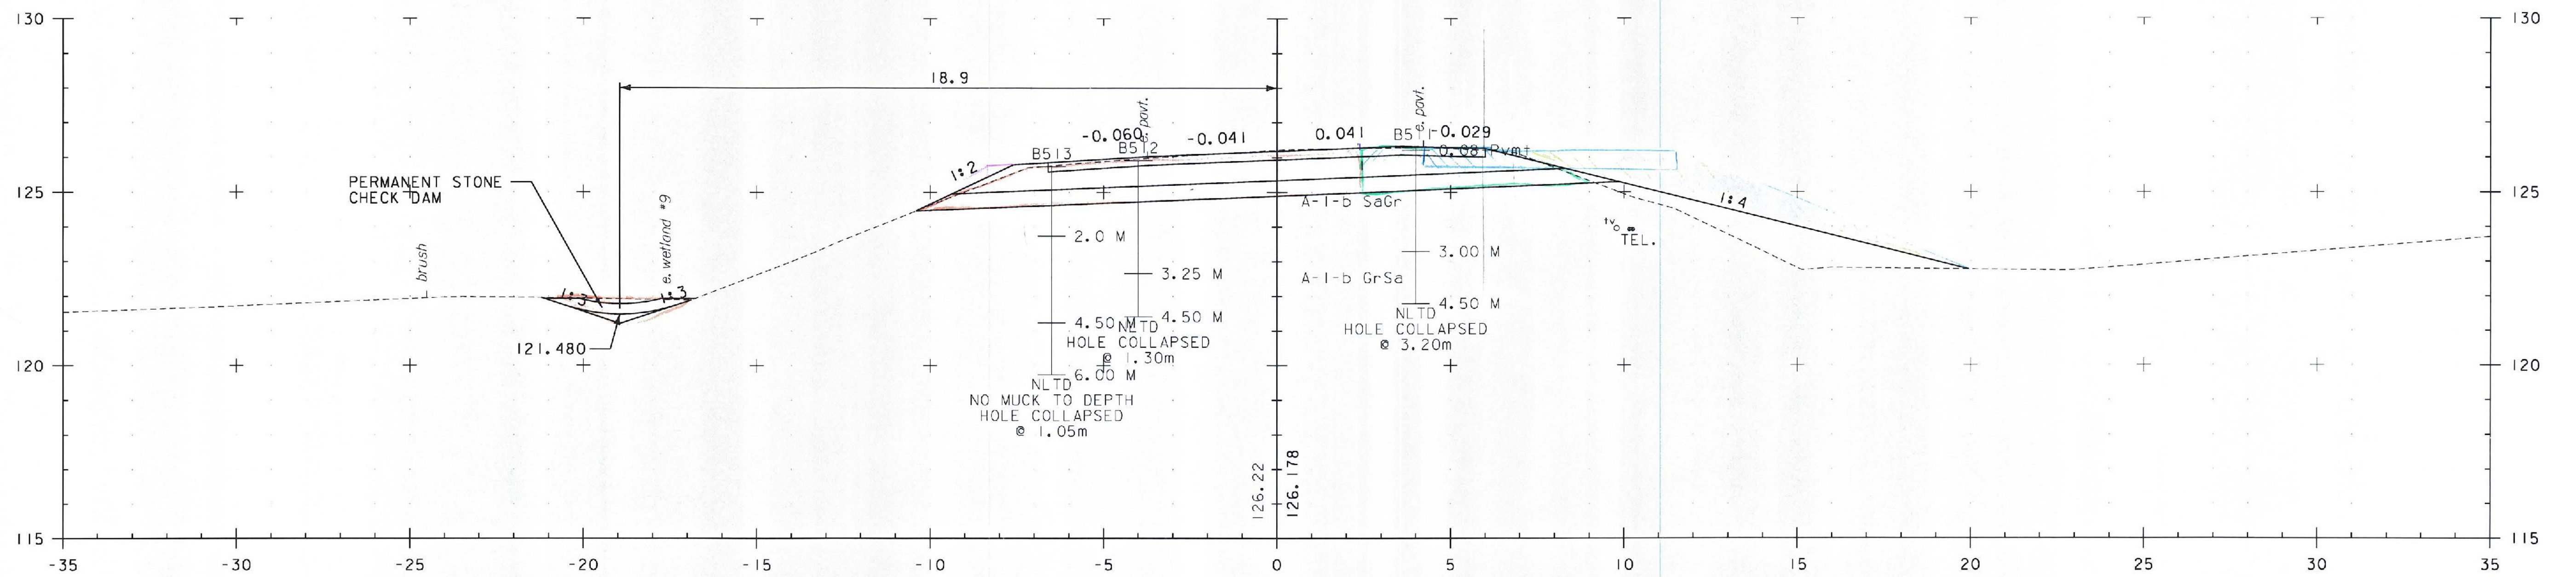

16+900.0

US 7

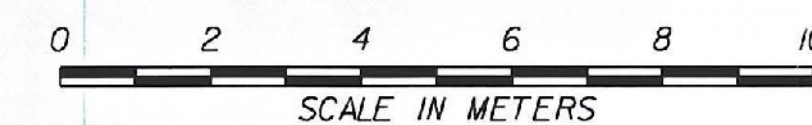

PROJECT NAME:	BRANDON	PLOT DATE:	9/3/2009
PROJECT NUMBER:	NH 019-3(495)	DRAWN BY:	NLL
FILE NAME:	z0008s5-xs020.dgn	DESIGNED BY:	PTS
PROJECT LEADER:	CRB	CHECKED BY:	DAM
CLD 02-019		SHEET	401 OF 546