
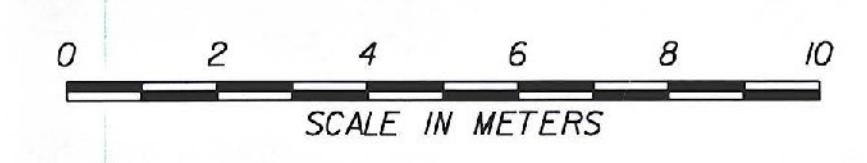
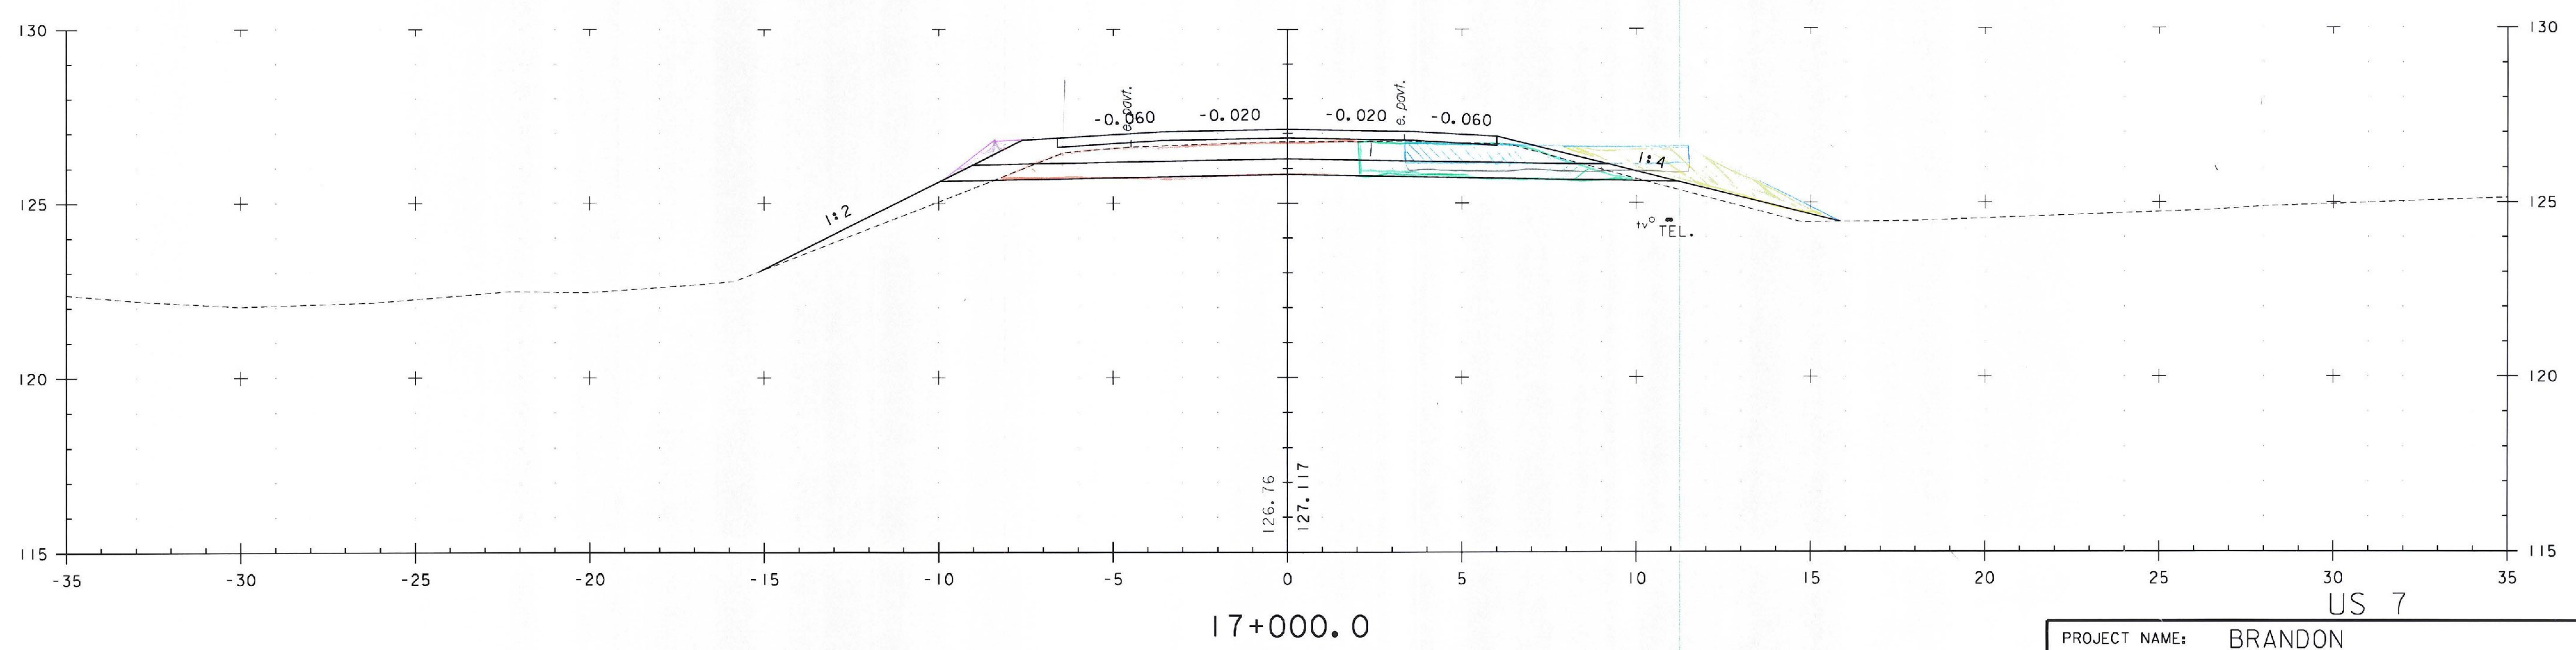


Handwritten notes on a green sticky note:
 2 (18.2m) - 2 (6.7m)
 6.35
 0.44
 0.12

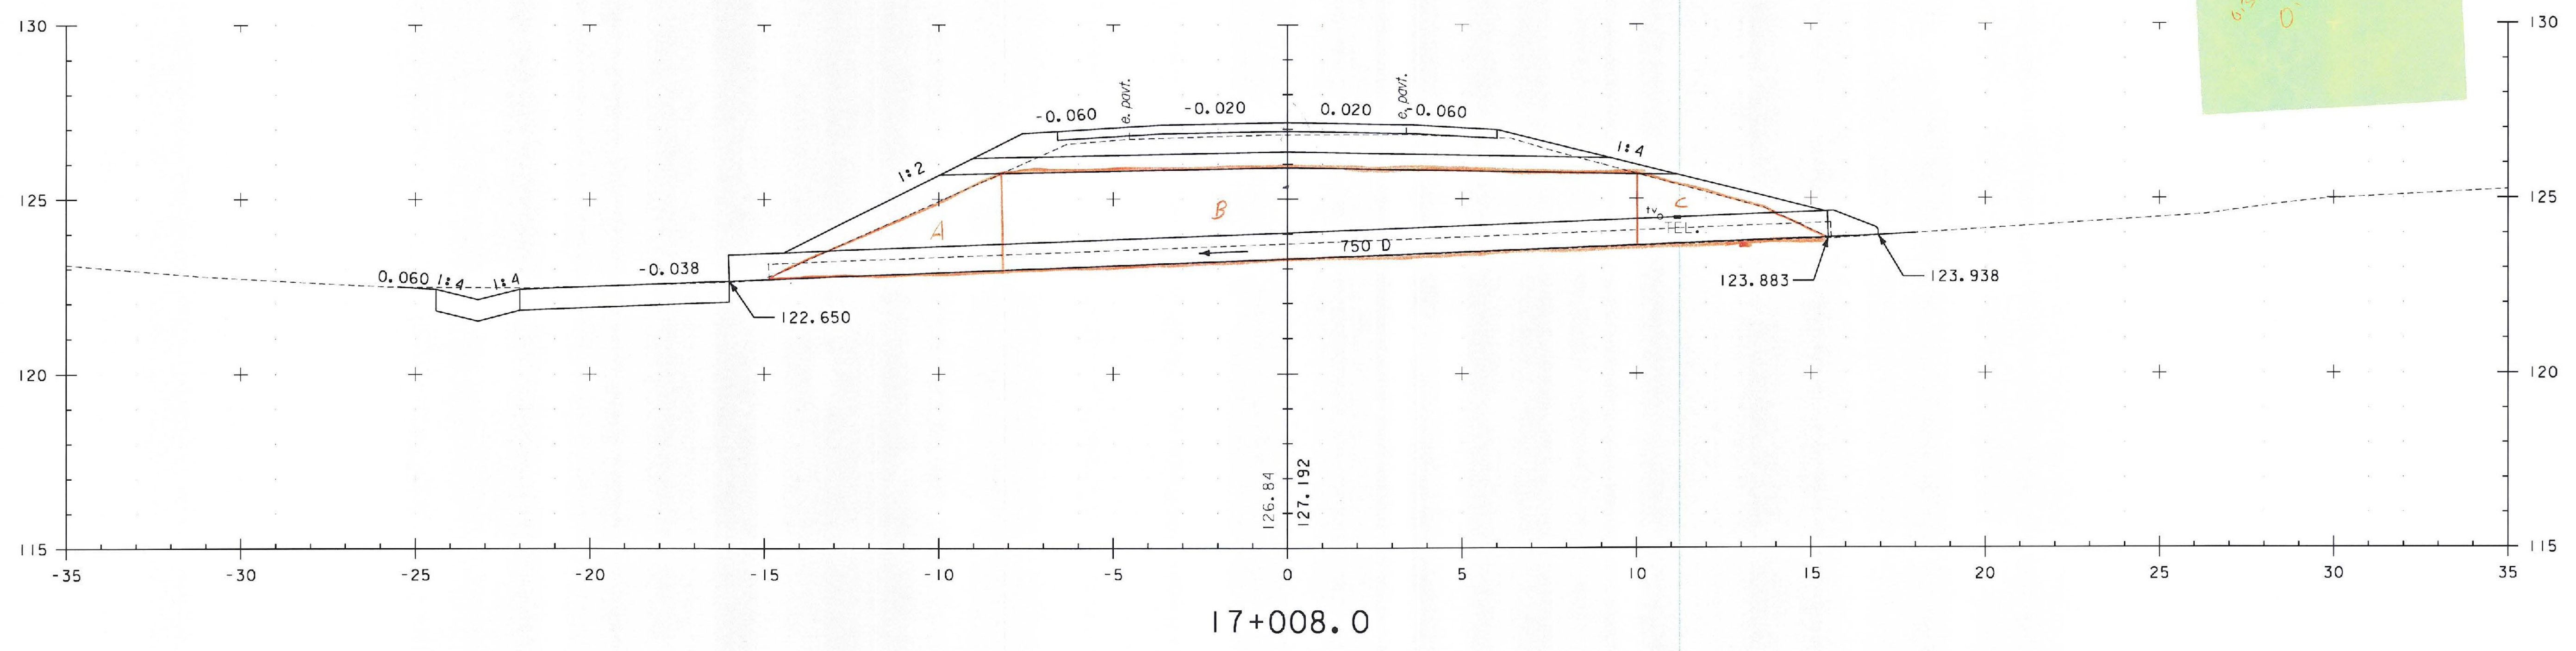

PROJECT NAME: BRANDON	PLOT DATE: 9/3/2009
PROJECT NUMBER: NH 019-3(495)	DRAWN BY: NLL
FILE NAME: zb008s5-xs023.dgn	CHECKED BY: DAM
PROJECT LEADER: CRB	SHEET 404 OF 546
DESIGNED BY: PTS	
CLD 02-049	