


US 7

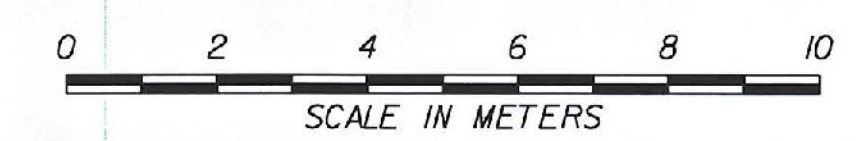

| | | | |
|-----------------|-------------------|--------------|------------|
| PROJECT NAME: | BRANDON | PLOT DATE: | 9/3/2009 |
| PROJECT NUMBER: | NH 019-3(495) | DRAWN BY: | NLL |
| FILE NAME: | zb008s5-xs031.dgn | DESIGNED BY: | PTS |
| PROJECT LEADER: | CRB | CHECKED BY: | DAM |
| CLD 02-0149 | | SHEET | 412 OF 546 |