


17+320.0  
DRIVE RT



17+315.5

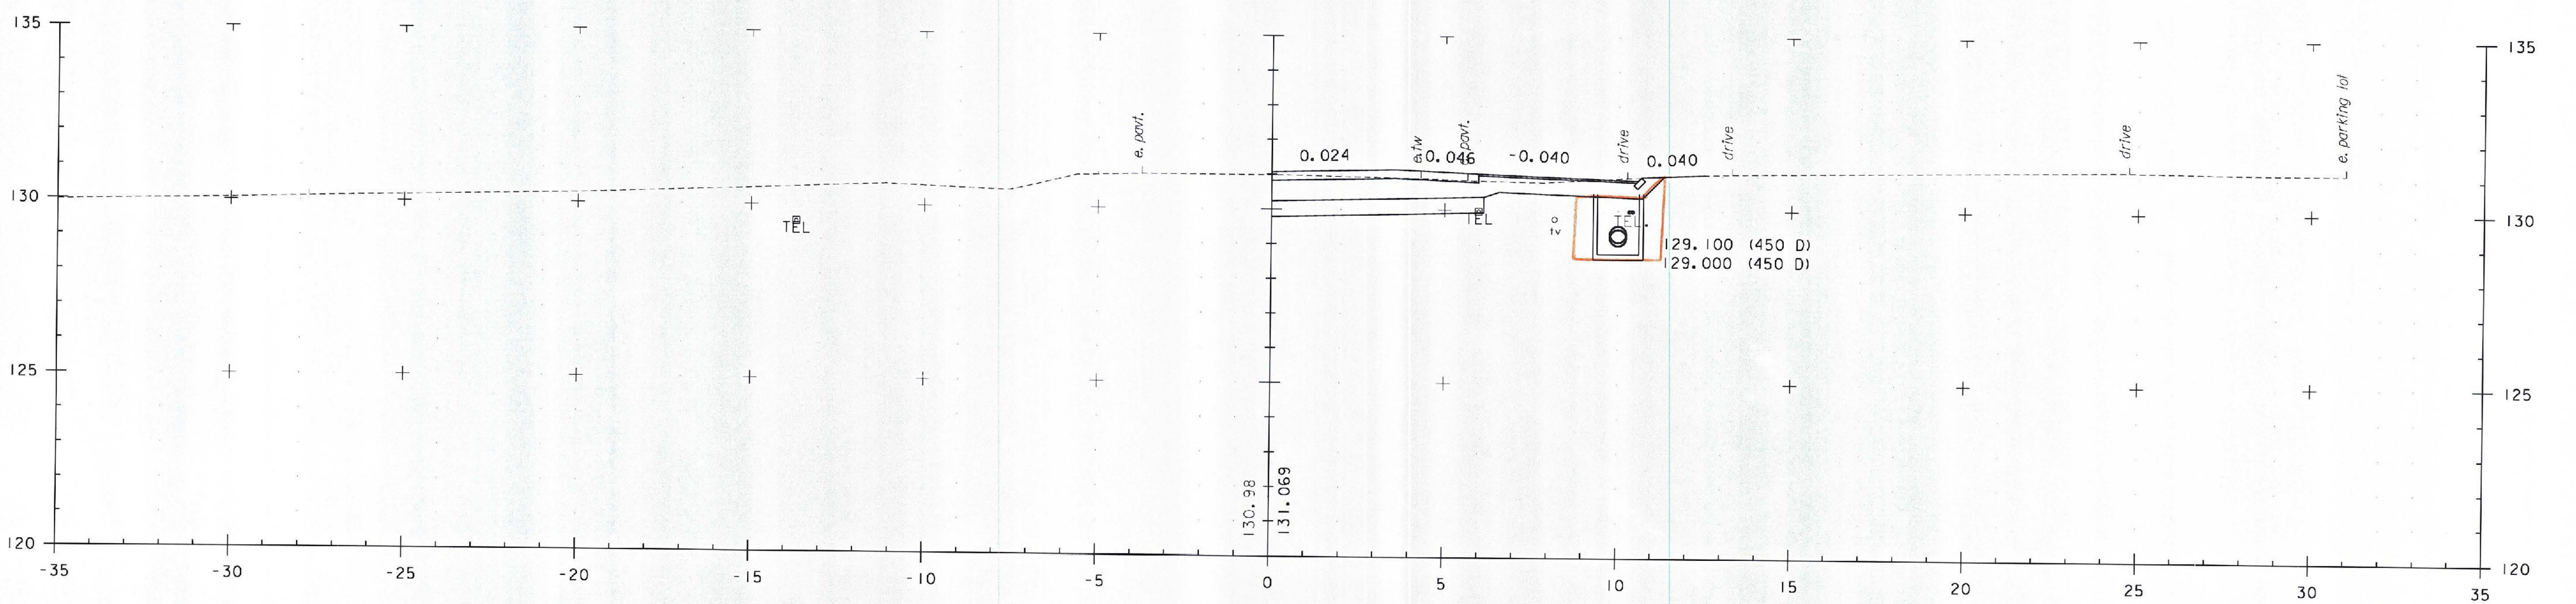

PROJECT NAME:	BRANDON	FILE NAME:	2b008s5-xs033.dgn	PLOT DATE:	9/3/2009
PROJECT NUMBER:	NH 019-3(495)	PROJECT LEADER:	CRB	DRAWN BY:	NLL
		DESIGNED BY:	PTS	CHECKED BY:	DAM
		CLD 02-049		SHEET 414	OF 546

US 7