



17+920.0

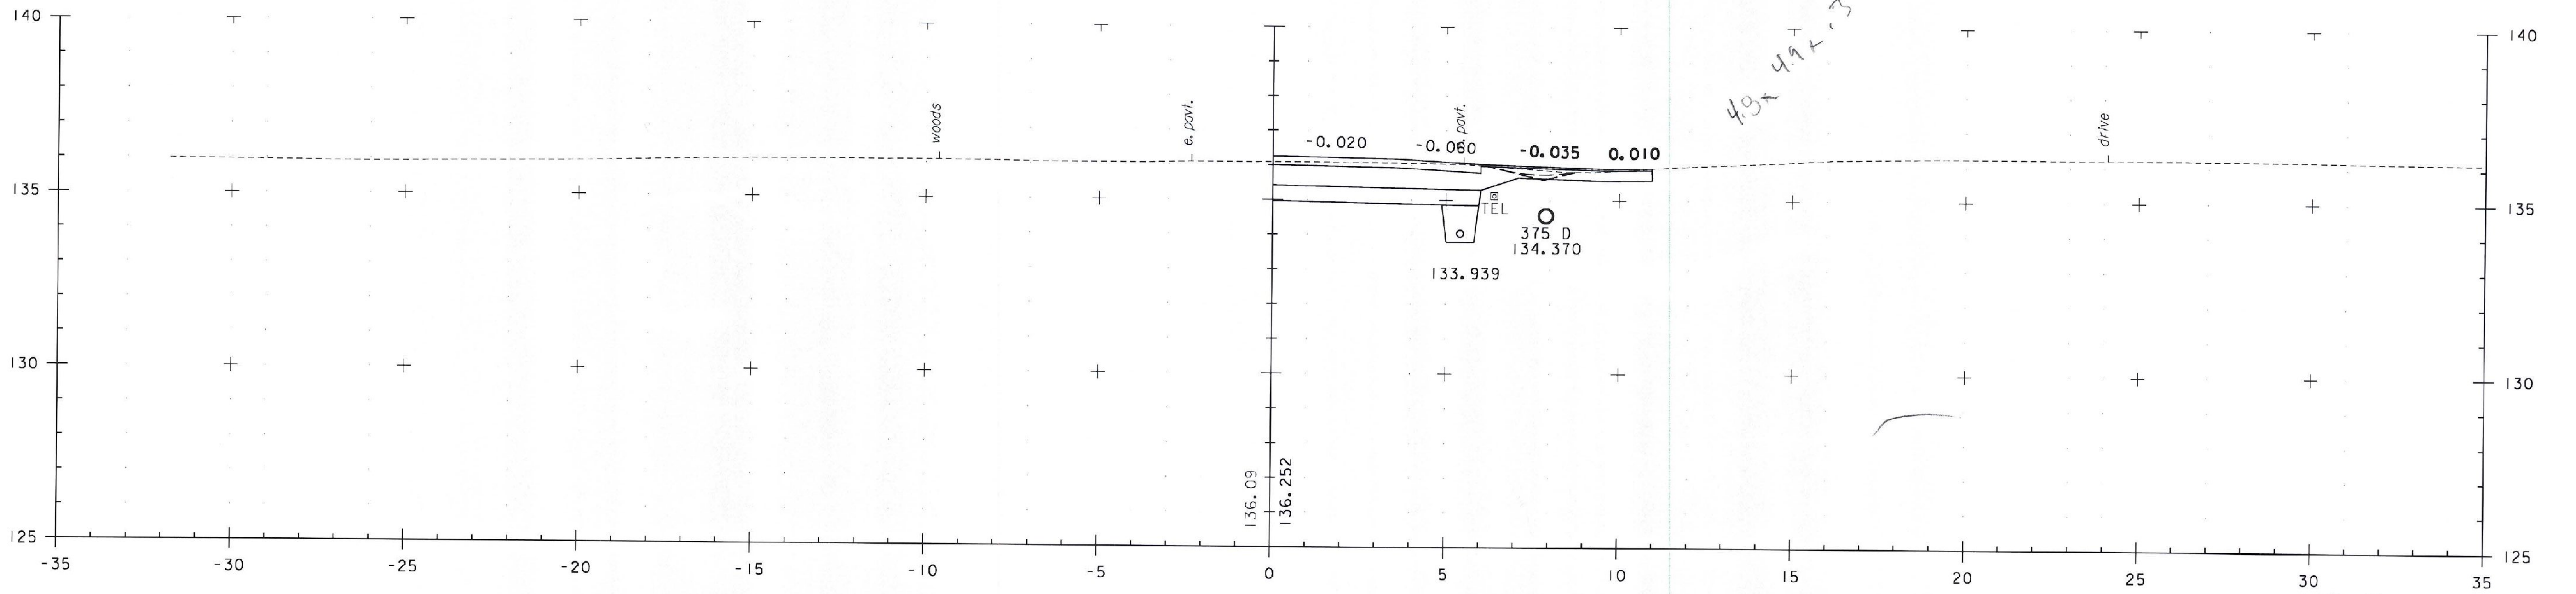

17+905.0
DRIVE RT

US 7

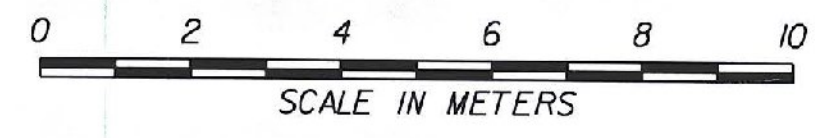

PROJECT NAME: BRANDON	PLOT DATE: 9/3/2009
PROJECT NUMBER: NH 019-3(495)	DRAWN BY: NLL
FILE NAME: zb008s5-xs052.dgn	DESIGNED BY: PTS
PROJECT LEADER: CRB	CHECKED BY: DAM
CLD 02-0149	SHEET 433 OF 546