


US 7

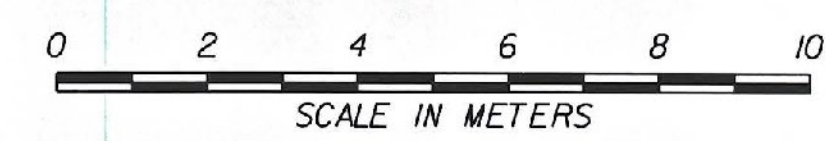

PROJECT NAME:	BRANDON	PLOT DATE:	9/3/2009
PROJECT NUMBER:	NH 019-3(495)	DRAWN BY:	NLL
FILE NAME:	zb008s5-xs064.dgn	DESIGNED BY:	PTS
PROJECT LEADER:	CRB	CHECKED BY:	DAM
CLD 02-0149		SHEET	445 OF 546