



18+480.0

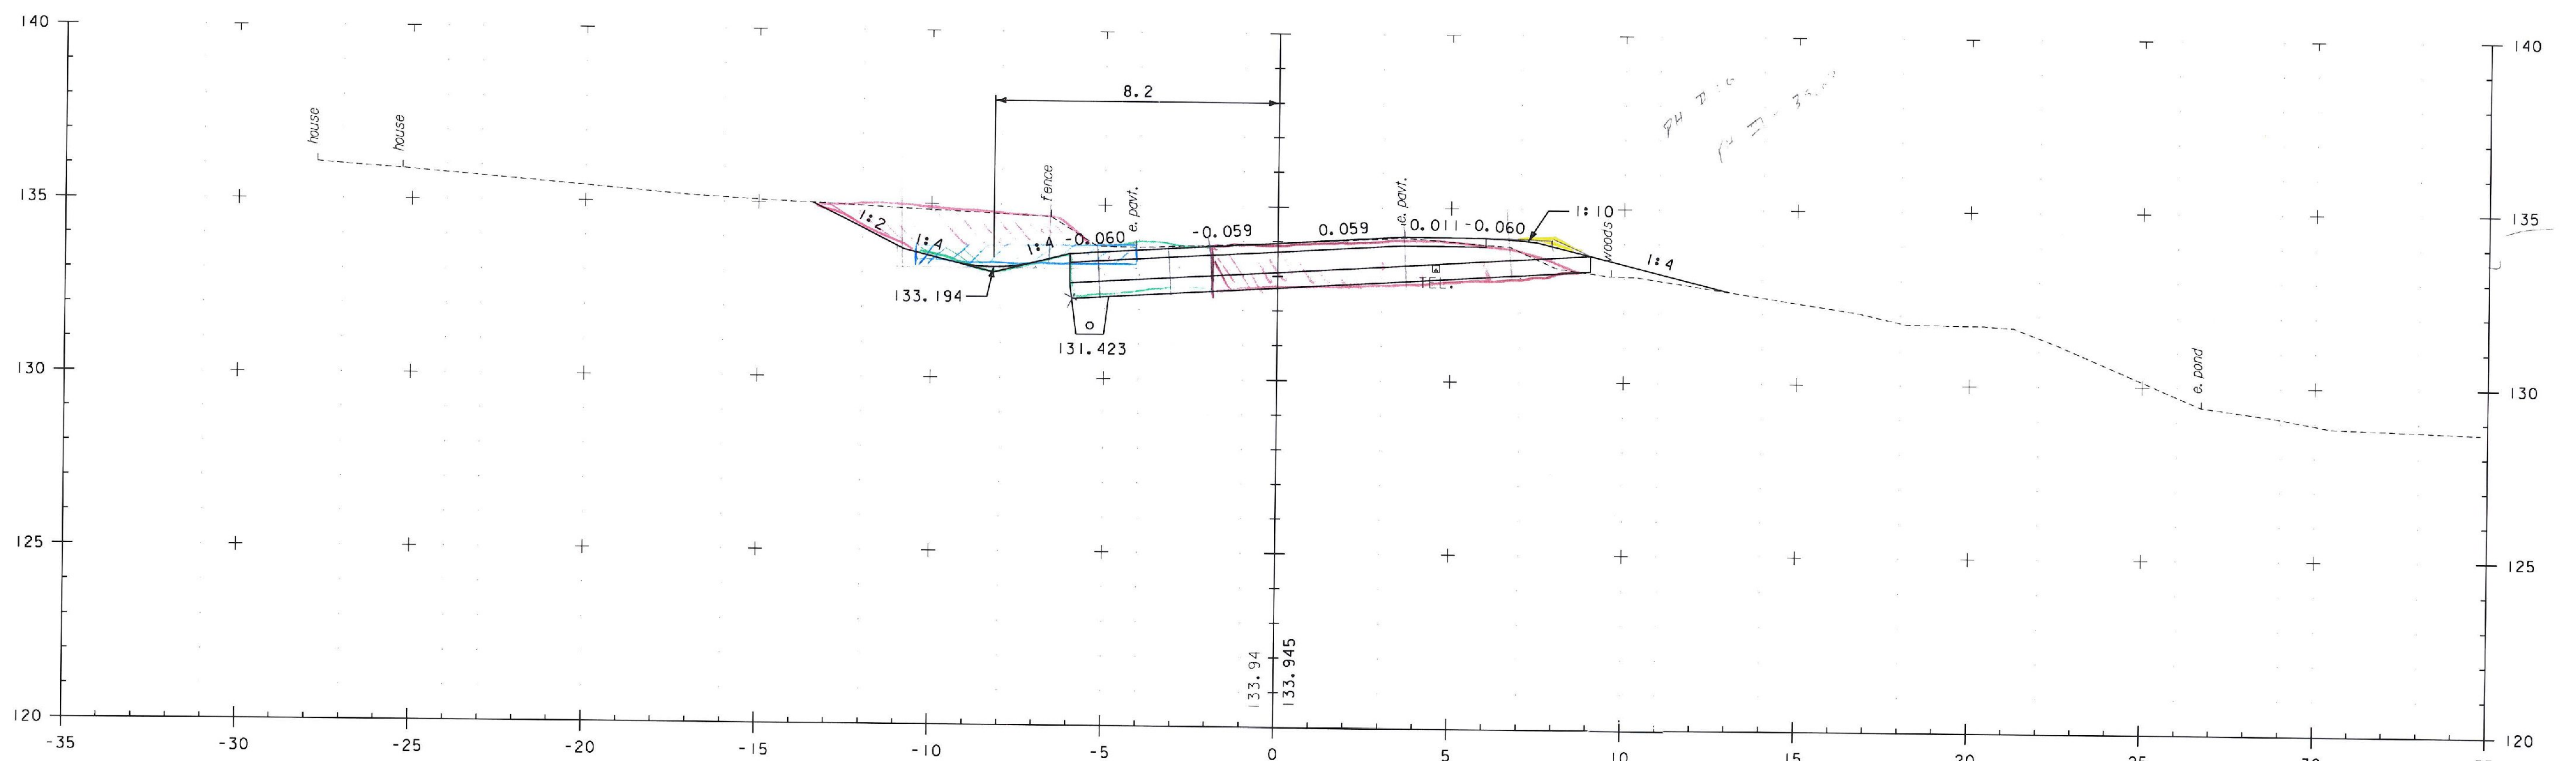

18+460.0

US 7

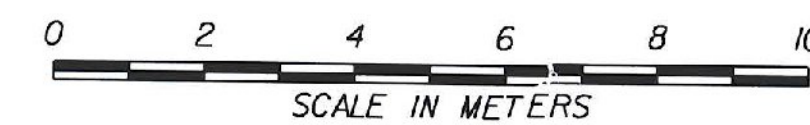

PROJECT NAME:	BRANDON	PLOT DATE:	9/3/2009
PROJECT NUMBER:	NH 019-3(495)	DRAWN BY:	NLL
FILE NAME:	zb008s5-xs071.dgn	DESIGNED BY:	PTS
PROJECT LEADER:	CRB	CHECKED BY:	DAM
CLD 02-0149		SHEET	452 OF 546