


18+681.6  
DRIVE LT

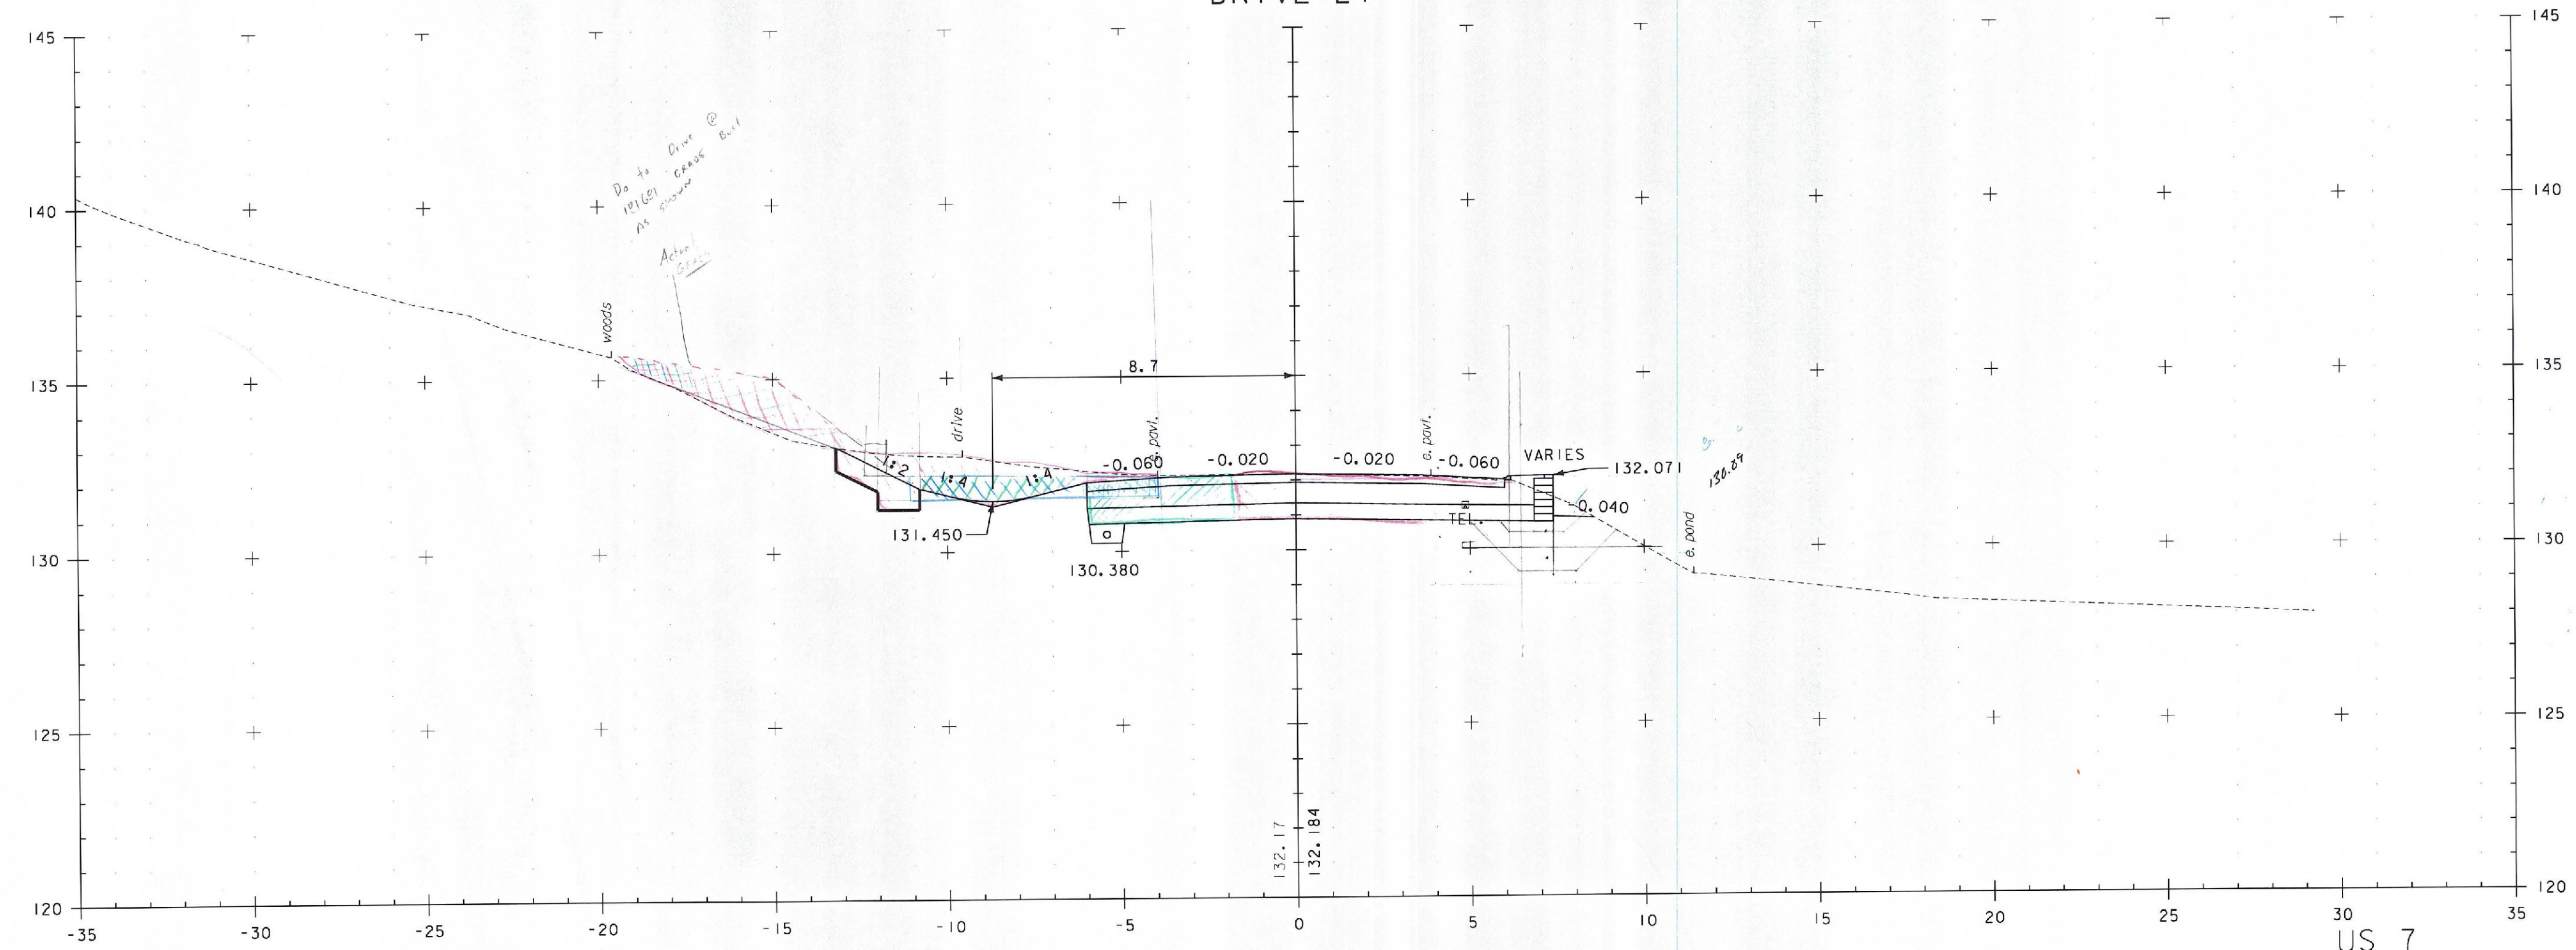

18+680.0



PROJECT NAME:	BRANDON	FILE NAME:	2b00855-xso8L.dgn	PLOT DATE:	9/3/2009
PROJECT NUMBER:	NH 019-3(495)	PROJECT LEADER:	CRB	DRAWN BY:	NLL
		DESIGNED BY:	PTS	CHECKED BY:	DAM
		CLD 02-049		SHEET	462 OF 546