


18+840.0



18+820.0

US 7

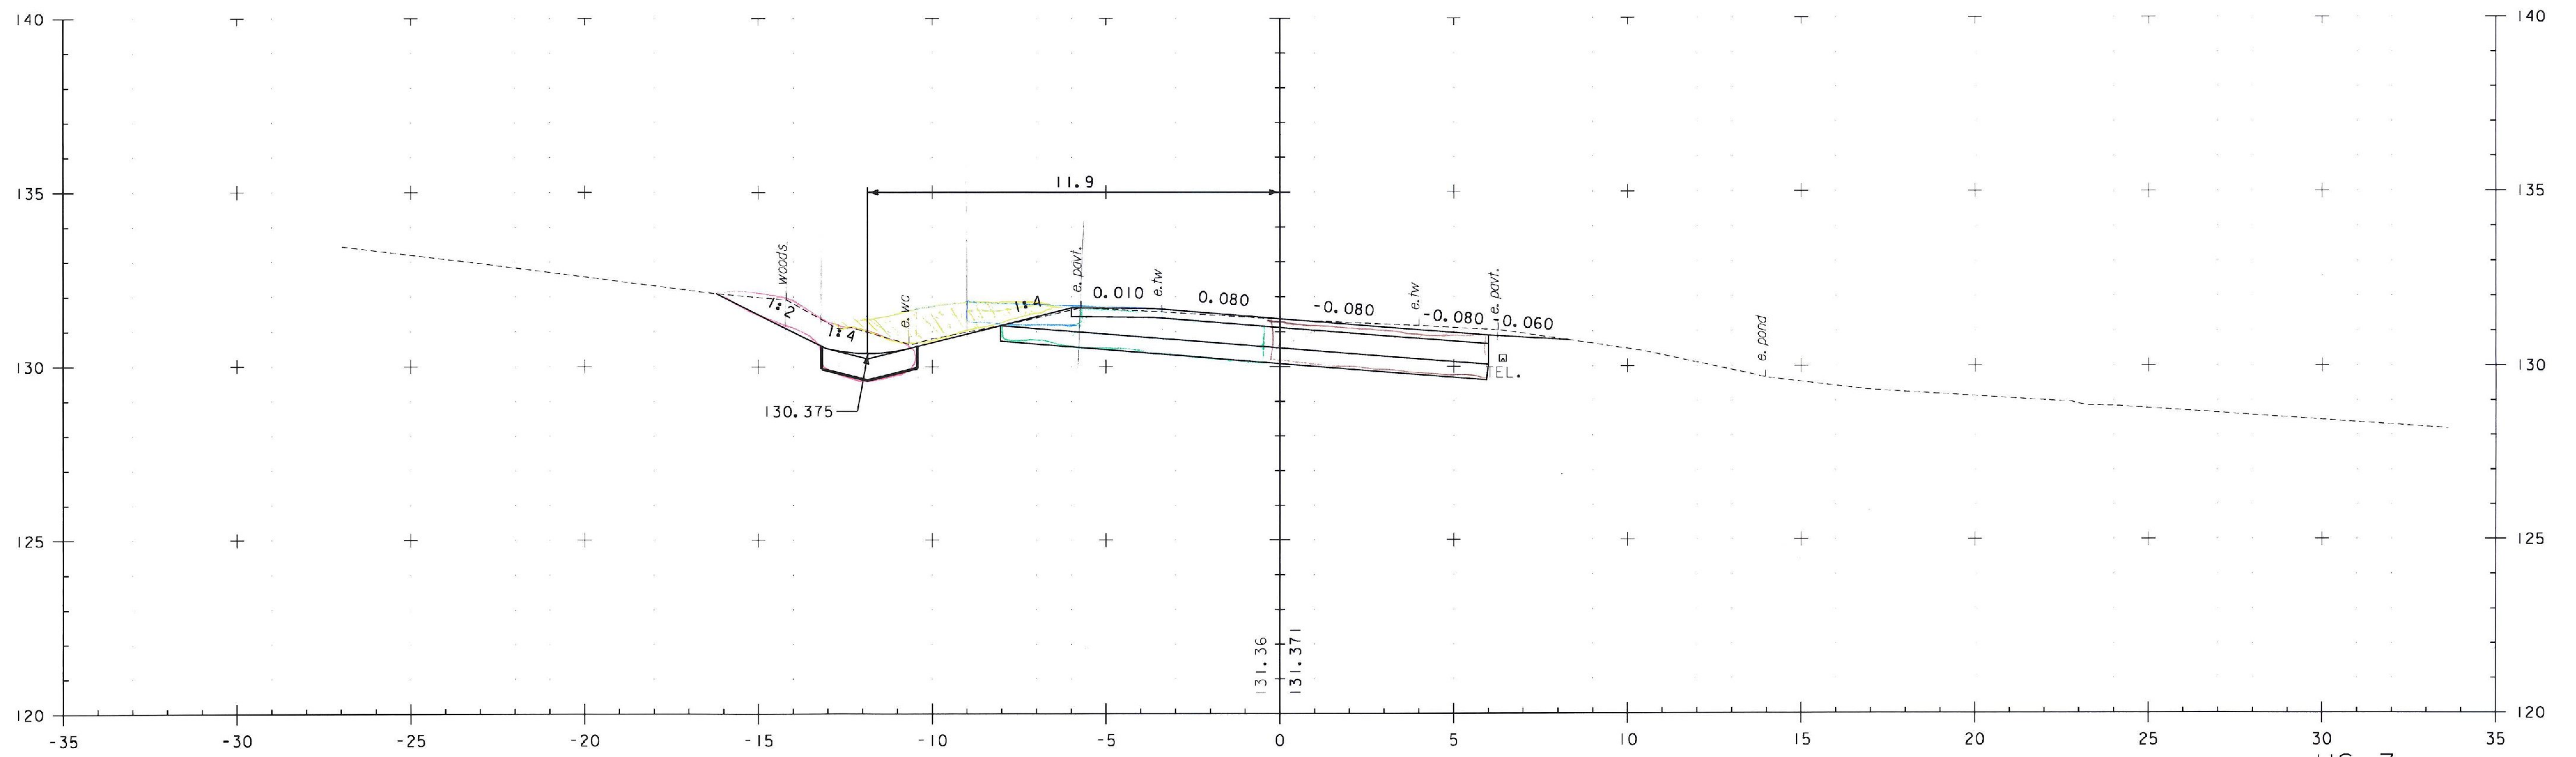

PROJECT NAME: BRANDON	PLOT DATE: 9/3/2009
PROJECT NUMBER: NH 019-3(495)	DRAWN BY: NLL
FILE NAME: zb008s5-xs087.dgn	CHECKED BY: DAM
PROJECT LEADER: CRB	SHEET 468 OF 546
DESIGNED BY: PTS	
CLD 02-049	