



7/14/21 X 3.6

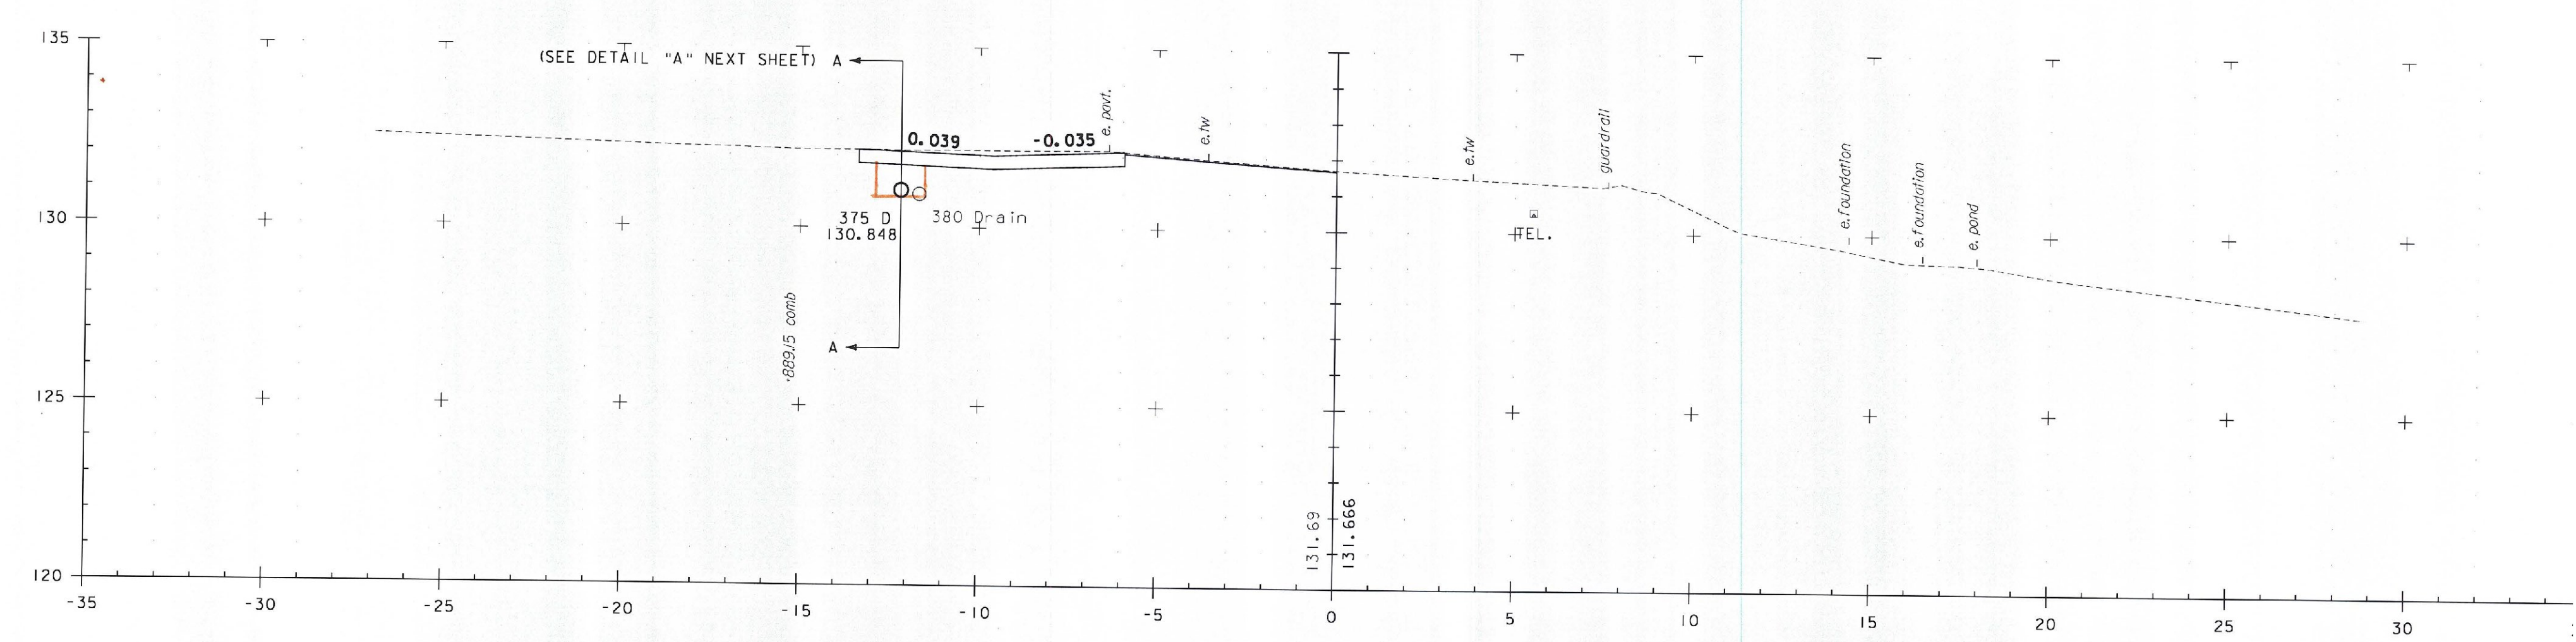


18+895.5
DRIVE LT

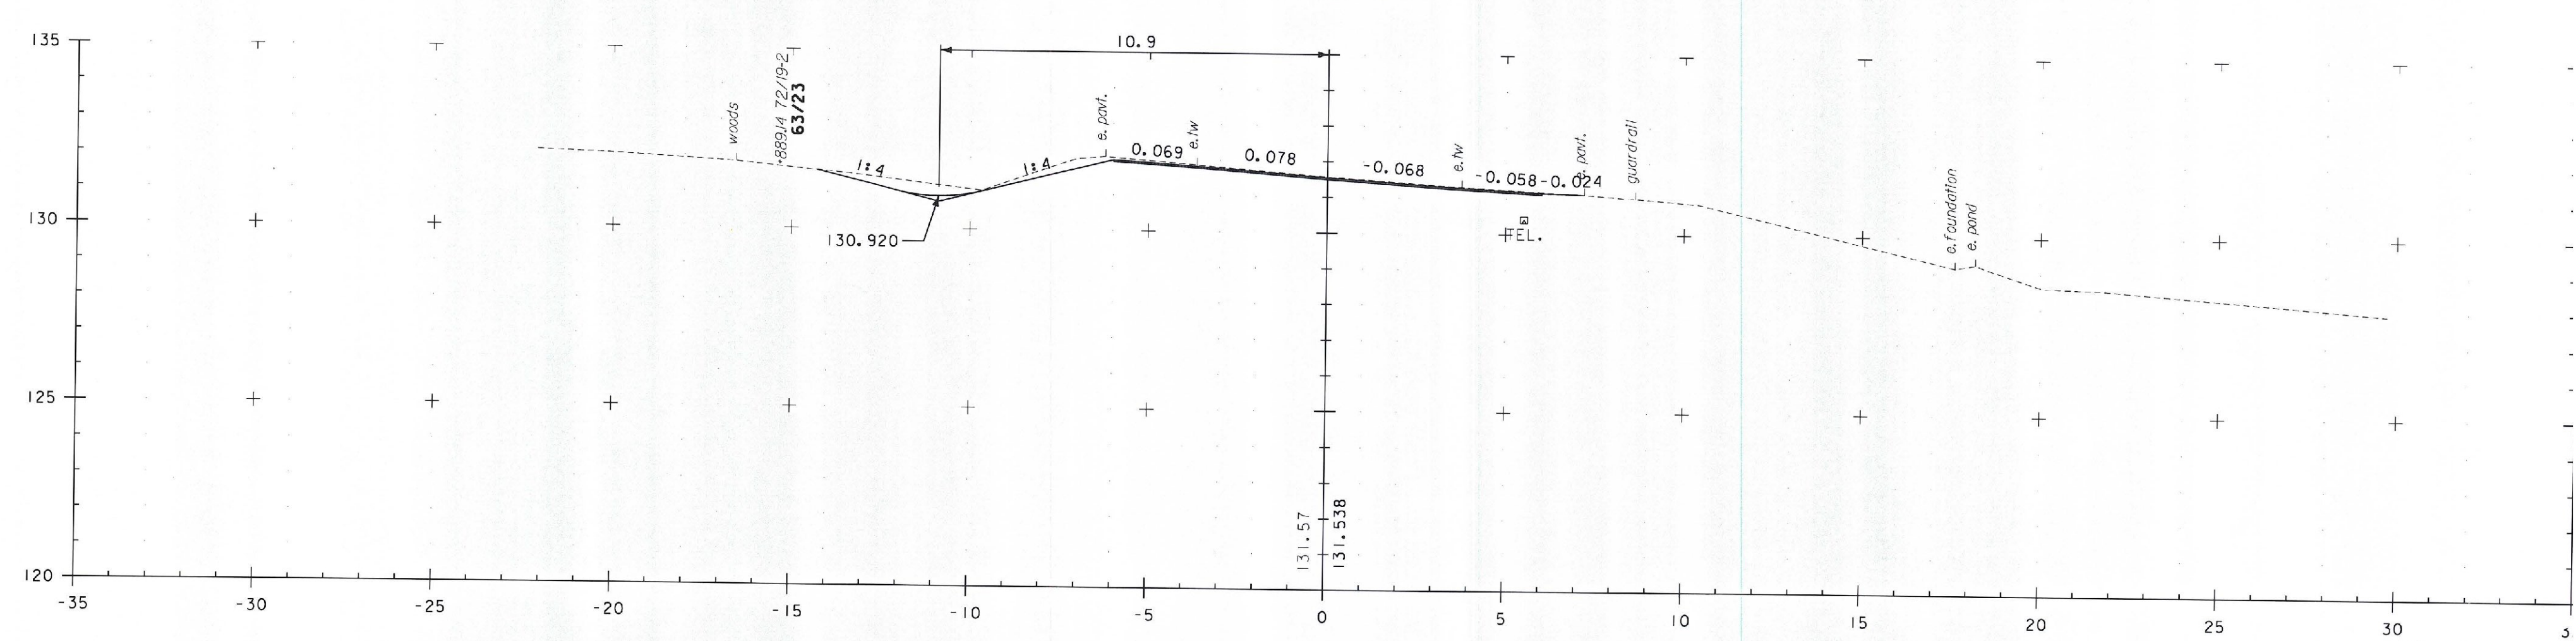

18+880.0

US 7

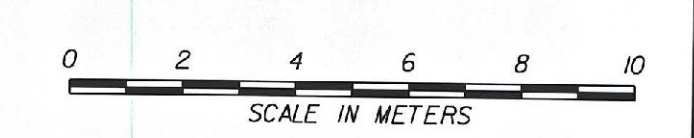

PROJECT NAME: BRANDON	PLOT DATE:
PROJECT NUMBER: NH 019-3(495)	DRAWN BY:
FILE NAME: zb008s5-xs089.dgn	CHECKED:
PROJECT LEADER: CRB	SHEET 4
DESIGNED BY: PTS	
CLD 02-0149	