


US 7

PROJECT NAME:	BRANDON	PROJECT NUMBER:	NH 019-3(495)
FILE NAME:	zb008s5-xs203.dgn	PROJECT LEADER:	CRB
DESIGNED BY:	PTS	CHECKED BY:	DAM
CLD 02-0149		PLOT DATE:	9/3/2009
		DRAWN BY:	NLL
		SHEET	474 OF 546

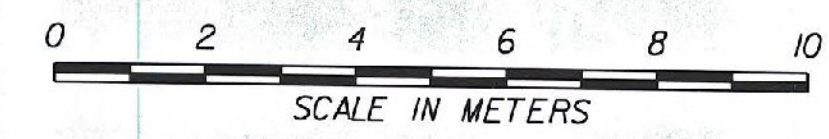

19+215.2
DRIVE RT