



19+680.0

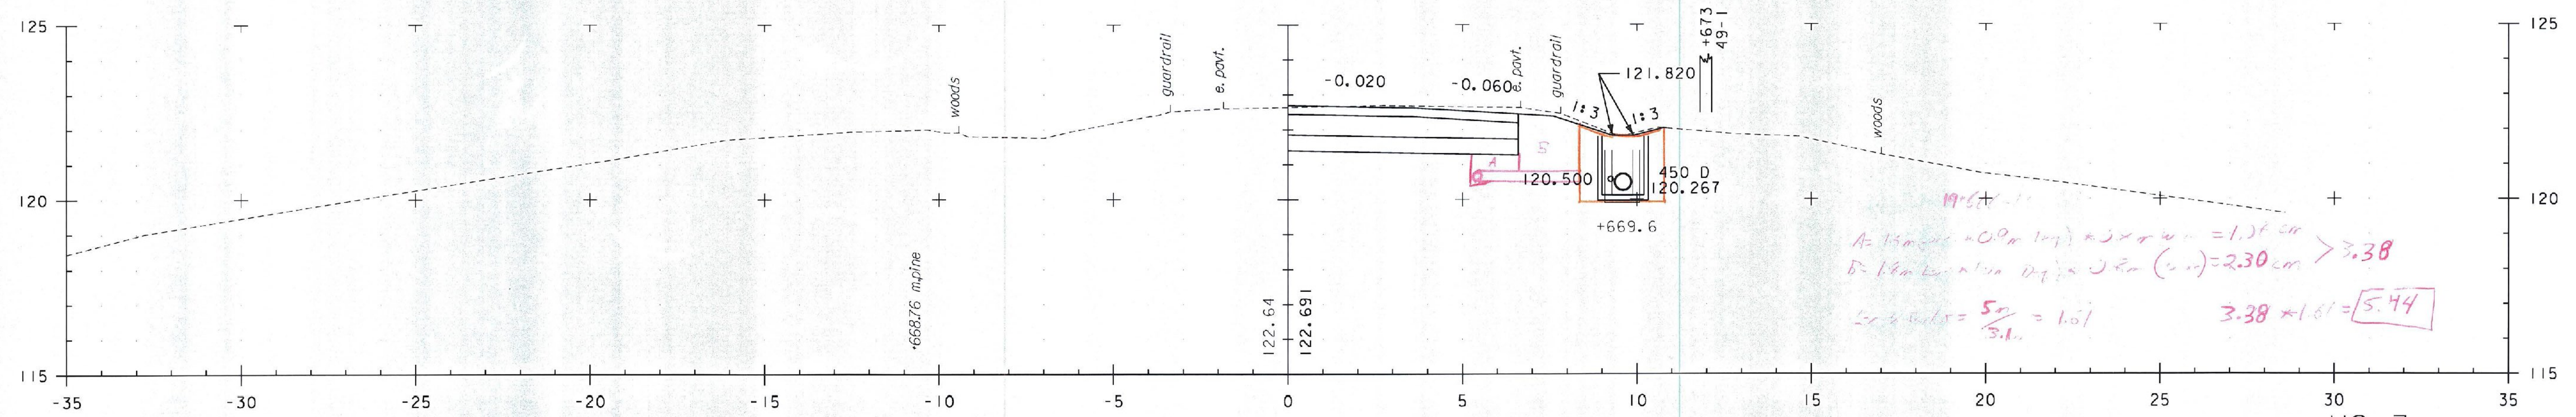

19+669.6

US 7

PROJECT NAME: BRANDON	PLOT DATE: 9/3/2009
PROJECT NUMBER: NH 019-3(495)	DRAWN BY: NLL
FILE NAME: zb008s5-xs215.dgn	CHECKED BY: DAM
PROJECT LEADER: CRB	SHEET 486 OF 546
DESIGNED BY: PTS	
CLD 02-0149	

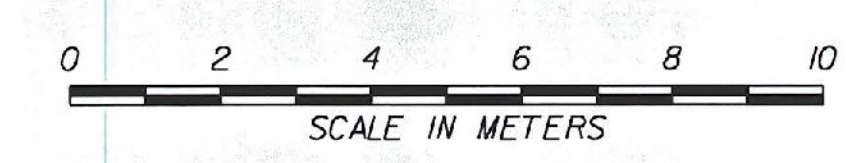

*(P) = 460 D (1x 460 D)
0.07' x 1.18' x 0.07' x 1.18'*

*19+669.6
A = 1.5m x 0.07m x 1.18m x 0.07m = 1.18' x 0.07'
B = 1.18m x 1.18m x 0.07m x 0.07m = 2.30' x 0.07' > 3.38
So 2 sides = 5.74 = 1.01' x 5.74 = 5.44*