


19+711.5
SKEWED



19+700.0

US 7

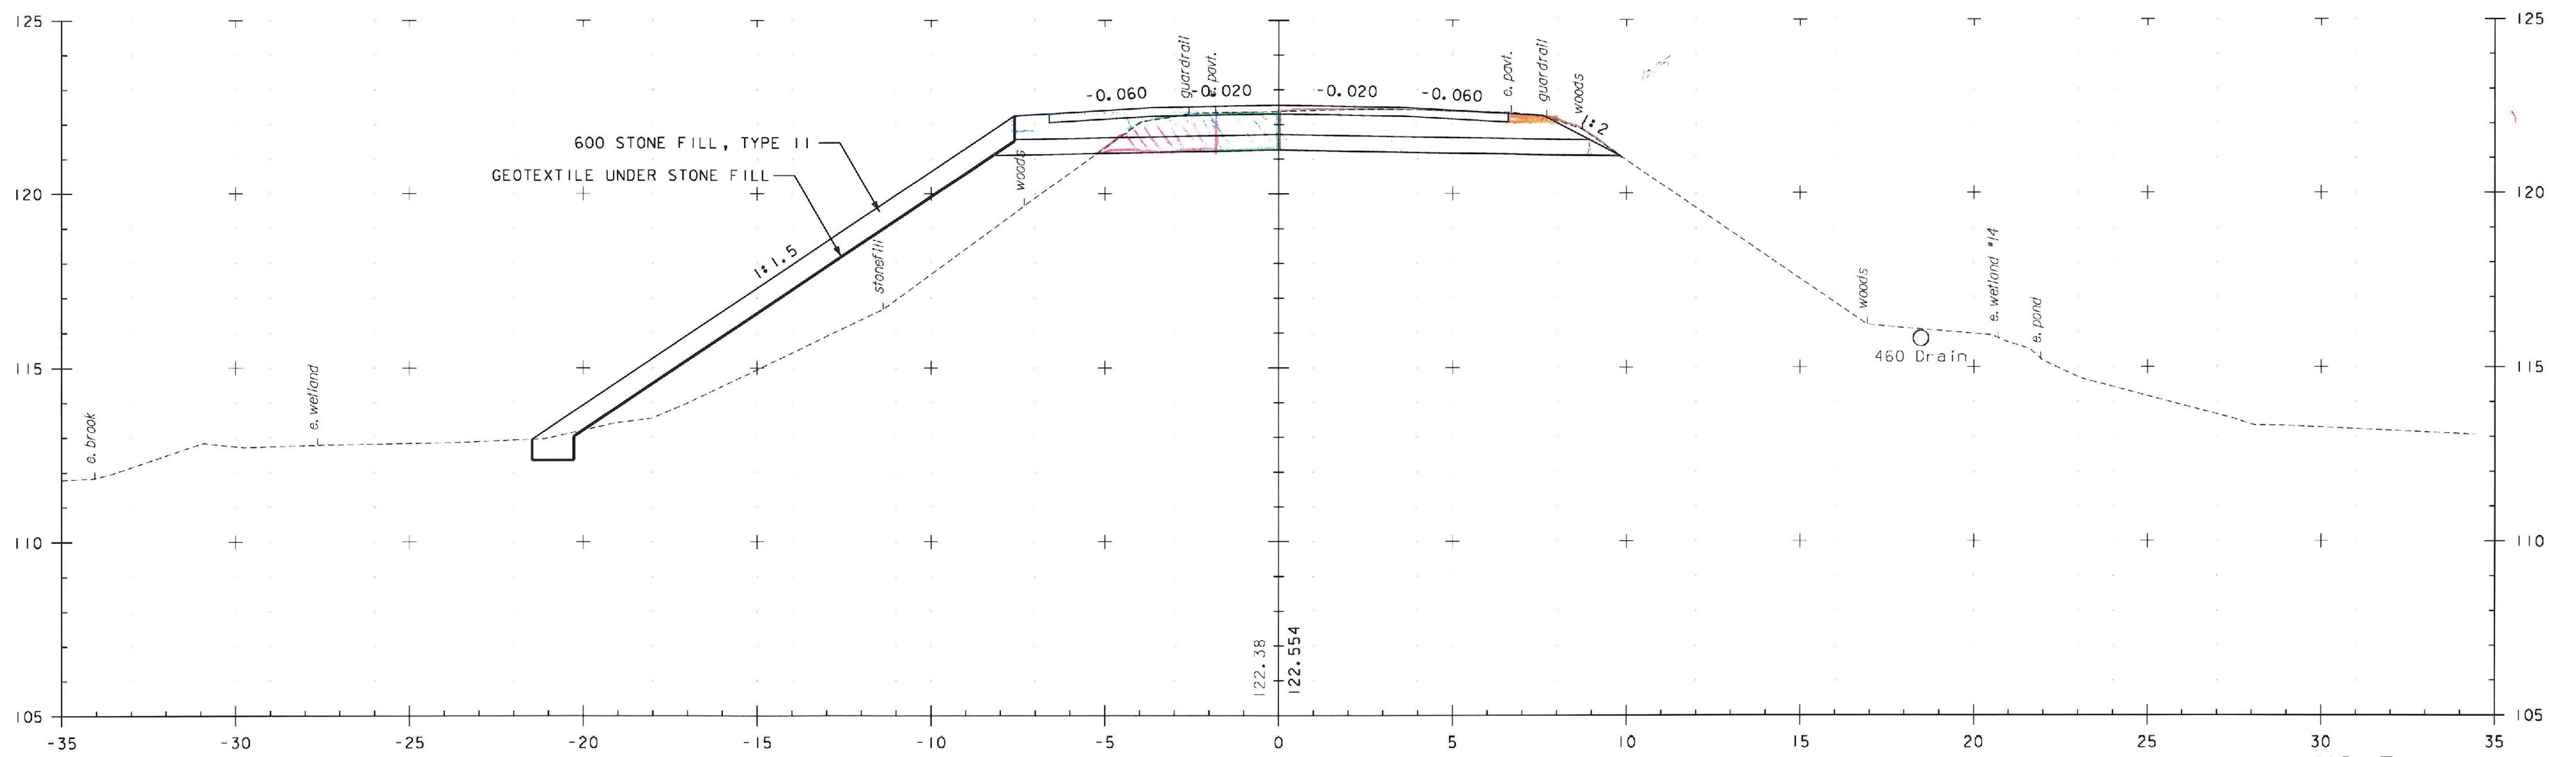

PROJECT NAME: BRANDON	PLOT DATE: 9/3/2009
PROJECT NUMBER: NH 019-3(495)	DRAWN BY: NLL
FILE NAME: zb008s5-xs216.dgn	CHECKED BY: DAM
PROJECT LEADER: CRB	SHEET 487 OF 546
DESIGNED BY: PTS	
CLD 02-0149	