



19+740.0

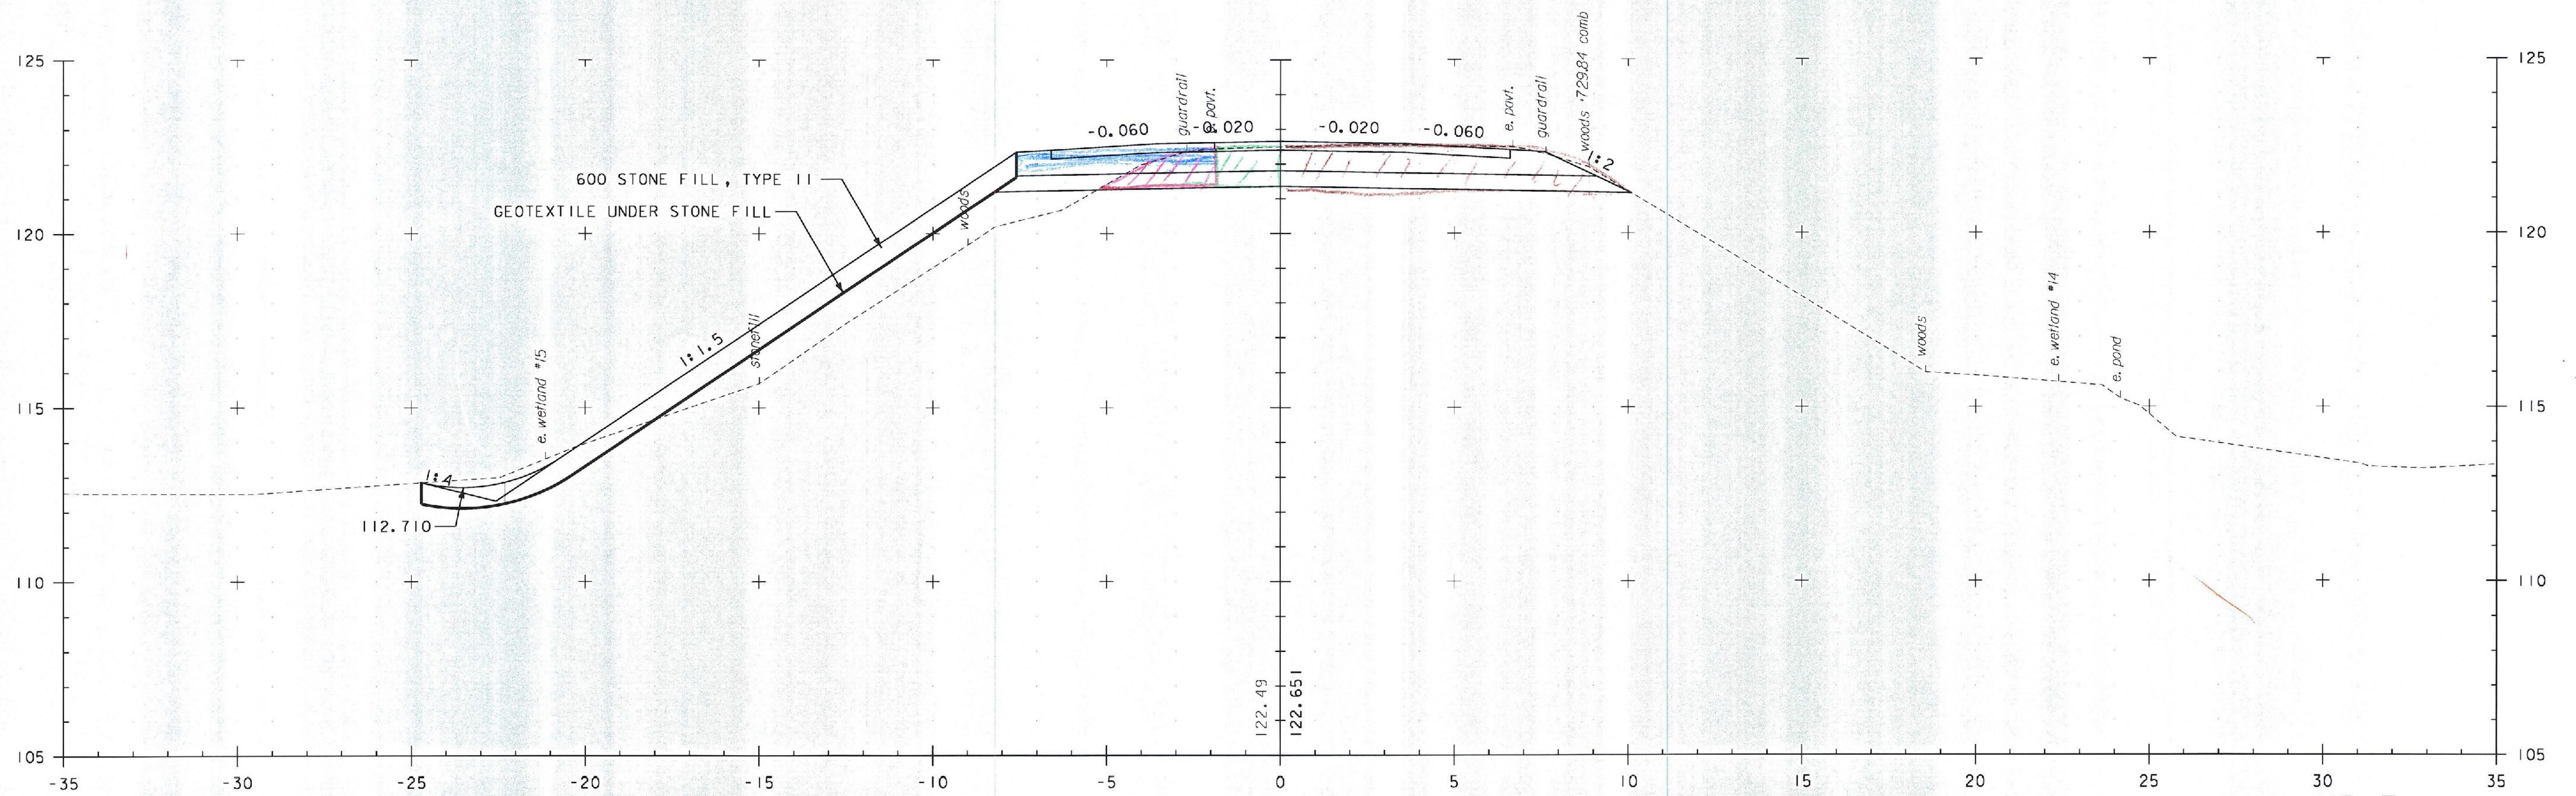

19+720.0

US 7

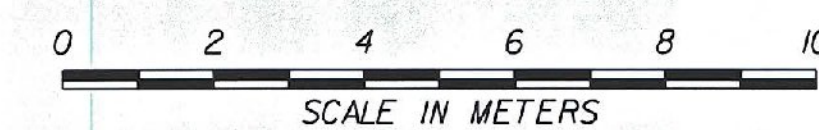

PROJECT NAME: BRANDON	PLOT DATE: 9/3/2009
PROJECT NUMBER: NH 019-3(495)	DRAWN BY: NLL
FILE NAME: zb008s5-xs217.dgn	DESIGNED BY: PTS
PROJECT LEADER: CRB	CHECKED BY: DAM
CLD 02-0149	SHEET 488 OF 546