



19+826.9
DRIVE RT

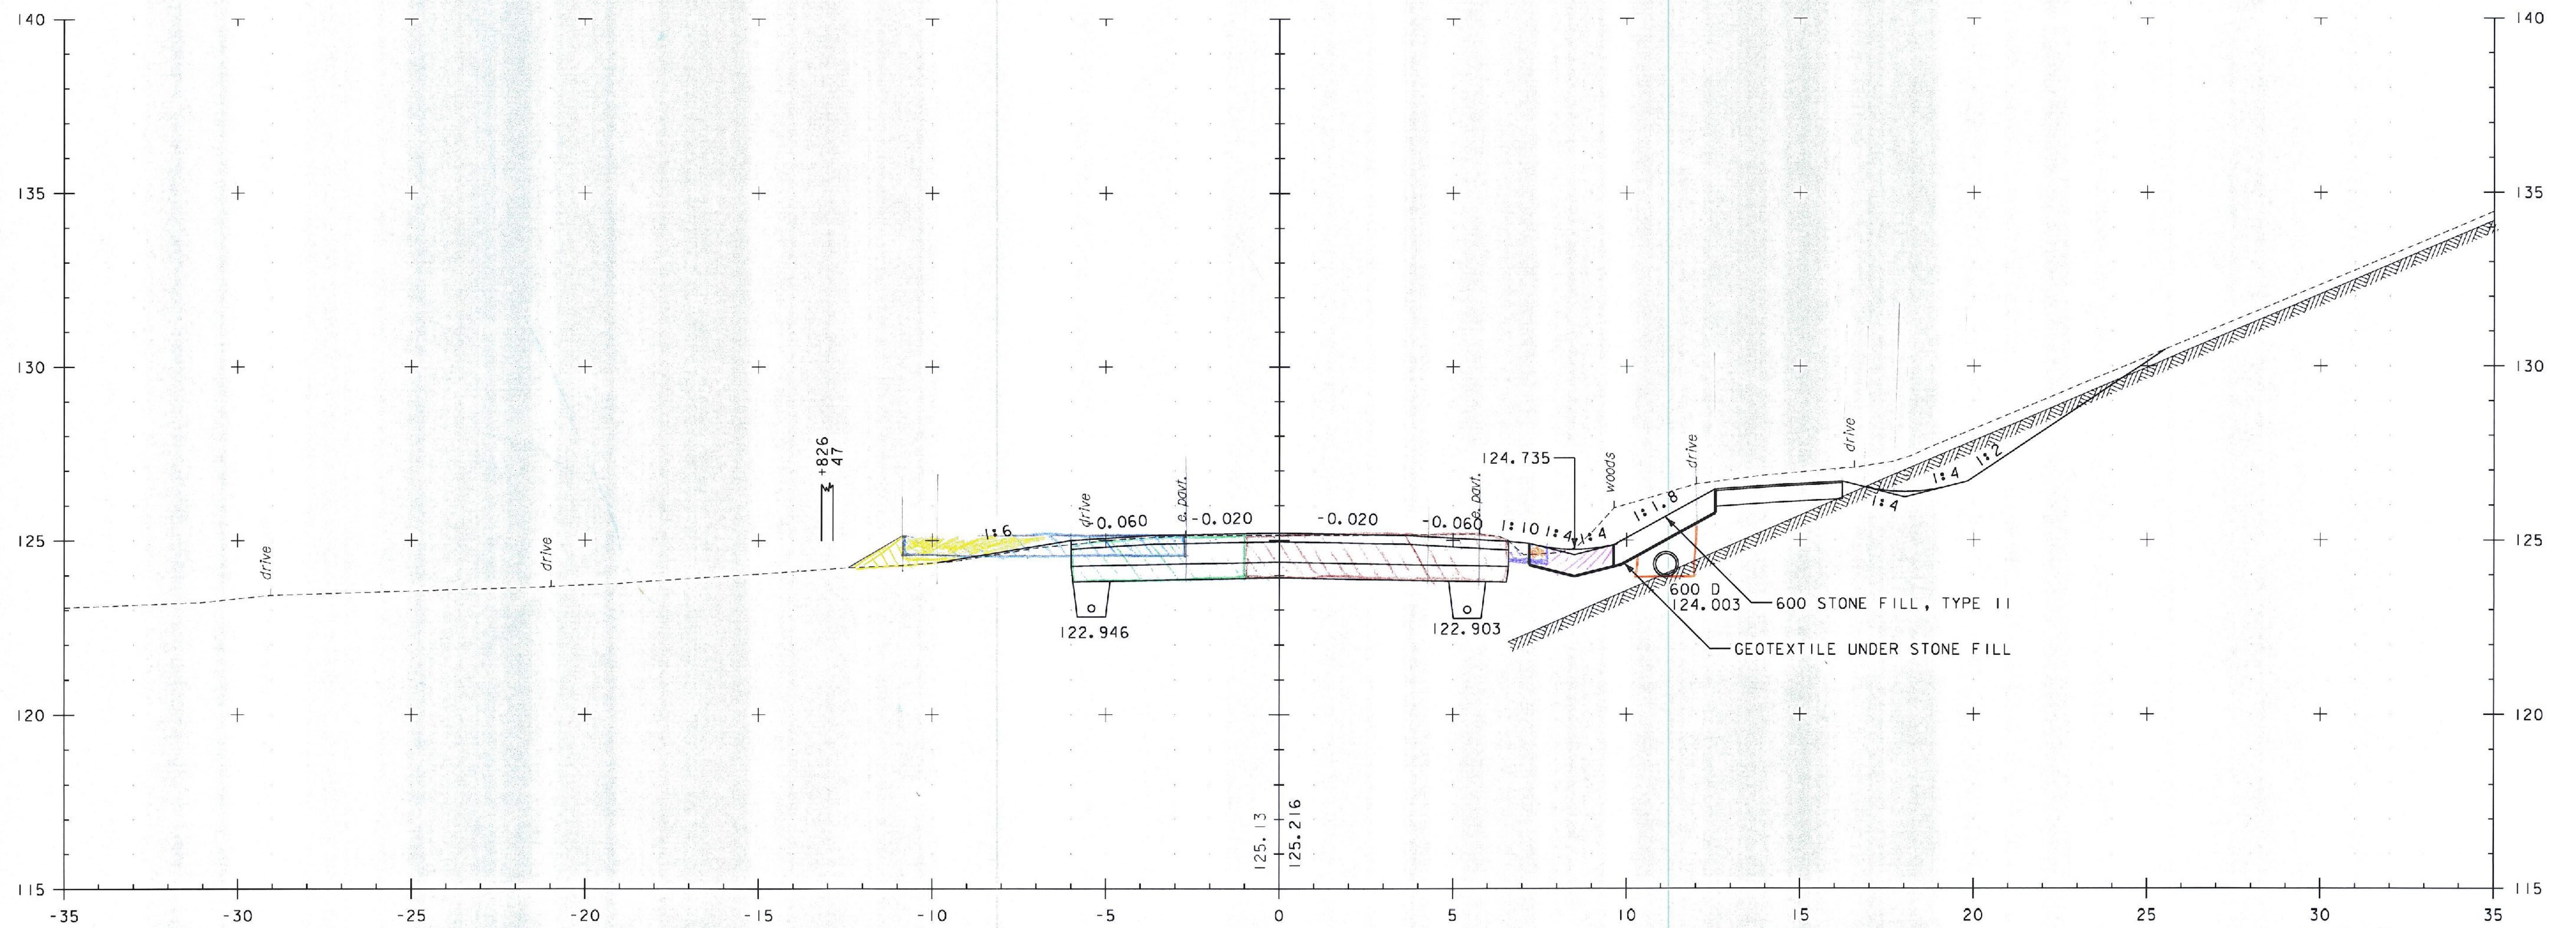

19+820.0

US 7

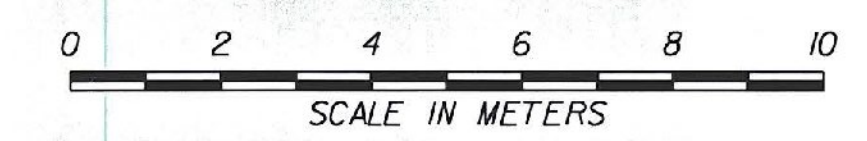

PROJECT NAME:	BRANDON	PLOT DATE:	9/3/2009
PROJECT NUMBER:	NH 019-3(495)	DRAWN BY:	NLL
FILE NAME:	zb008s5-xs221.dgn	CHECKED BY:	DAM
PROJECT LEADER:	CRB	DESIGNED BY:	PTS
DESIGNED BY:	PTS	CHECKED BY:	DAM
CLD 02-0149		SHEET	492 OF 546