



20+040.0

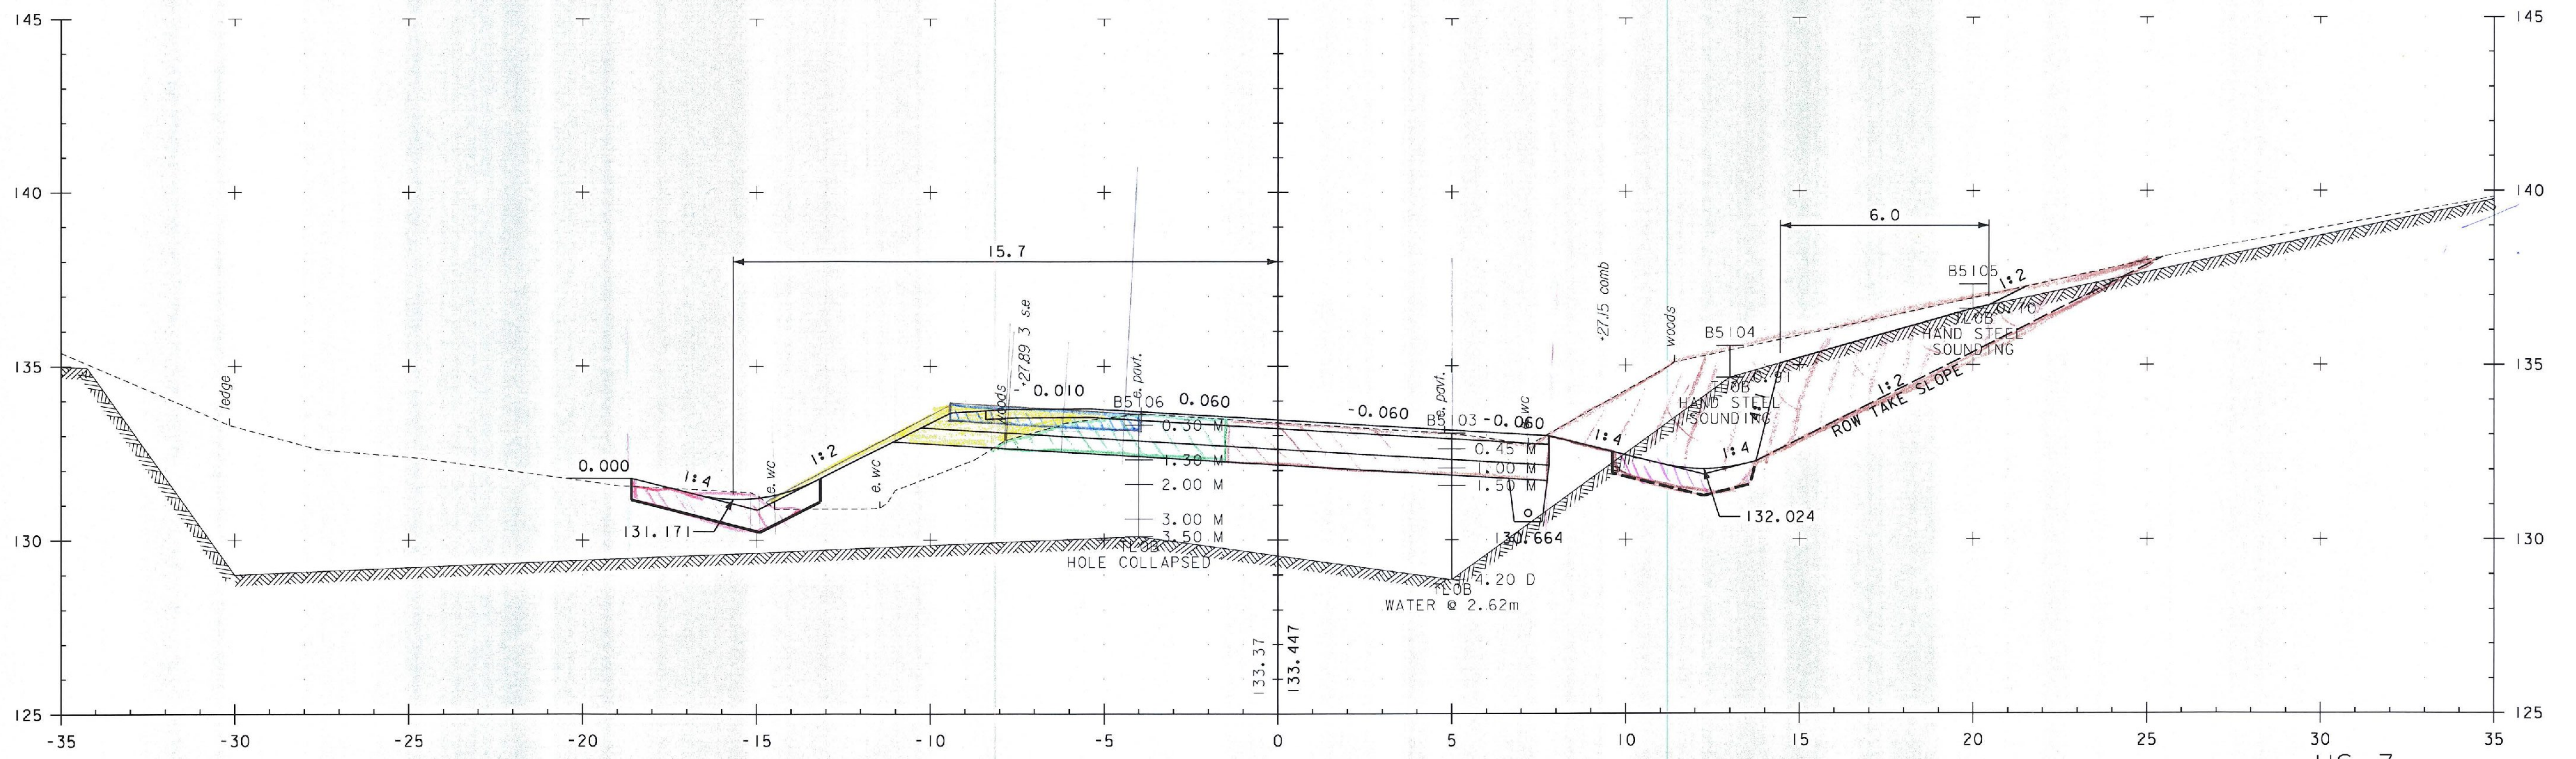

20+020.0

US 7

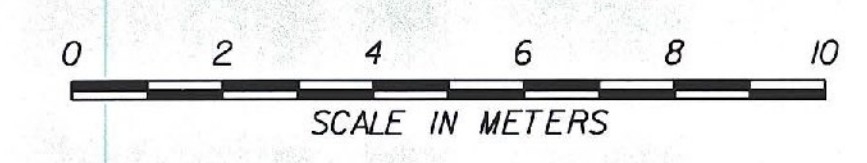

PROJECT NAME:	BRANDON	FILE NAME:	zb008s5-xs232.dgn	PLOT DATE:	9/3/2009
PROJECT NUMBER:	NH 019-3(495)	PROJECT LEADER:	CRB	DRAWN BY:	NLL
		DESIGNED BY:	PTS	CHECKED BY:	DAM
		CLD 02-049		SHEET	503 OF 546