


A = 2.9 (Long) x 5m (Depth) = 14.75
Length Factor = 8/49 = 0.16
1.16 x 12.78 = 14.82

20+320.0

US 7

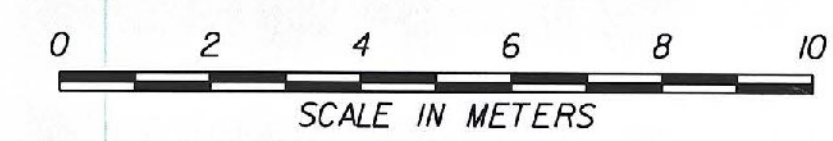

| | | | |
|-----------------|-------------------|-------------|------------|
| PROJECT NAME: | BRANDON | PLOT DATE: | 9/3/2009 |
| PROJECT NUMBER: | NH 019-3(495) | DRAWN BY: | NLL |
| FILE NAME: | zb008s5-xs247.dgn | CHECKED BY: | DAM |
| PROJECT LEADER: | CRB | SHEET | 518 OF 546 |
| DESIGNED BY: | PTS | | |
| CLD | 02-0149 | | |