


20+440.0

US 7

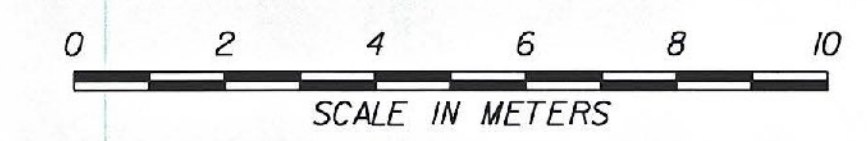

PROJECT NAME:	BRANDON	
PROJECT NUMBER:	NH 019-3(495)	
FILE NAME:	zb008s5-xs256.dgn	PLOT DATE:
PROJECT LEADER:	CRB	DRAWN BY:
DESIGNED BY:	PTS	CHECKED BY:
CLD 02-049		SHEET 527 OF 546