




20+780.0
 POT 20+777.617 (BK)
 POT 20+778.000 (AHD)
 EQ = -0.383 m

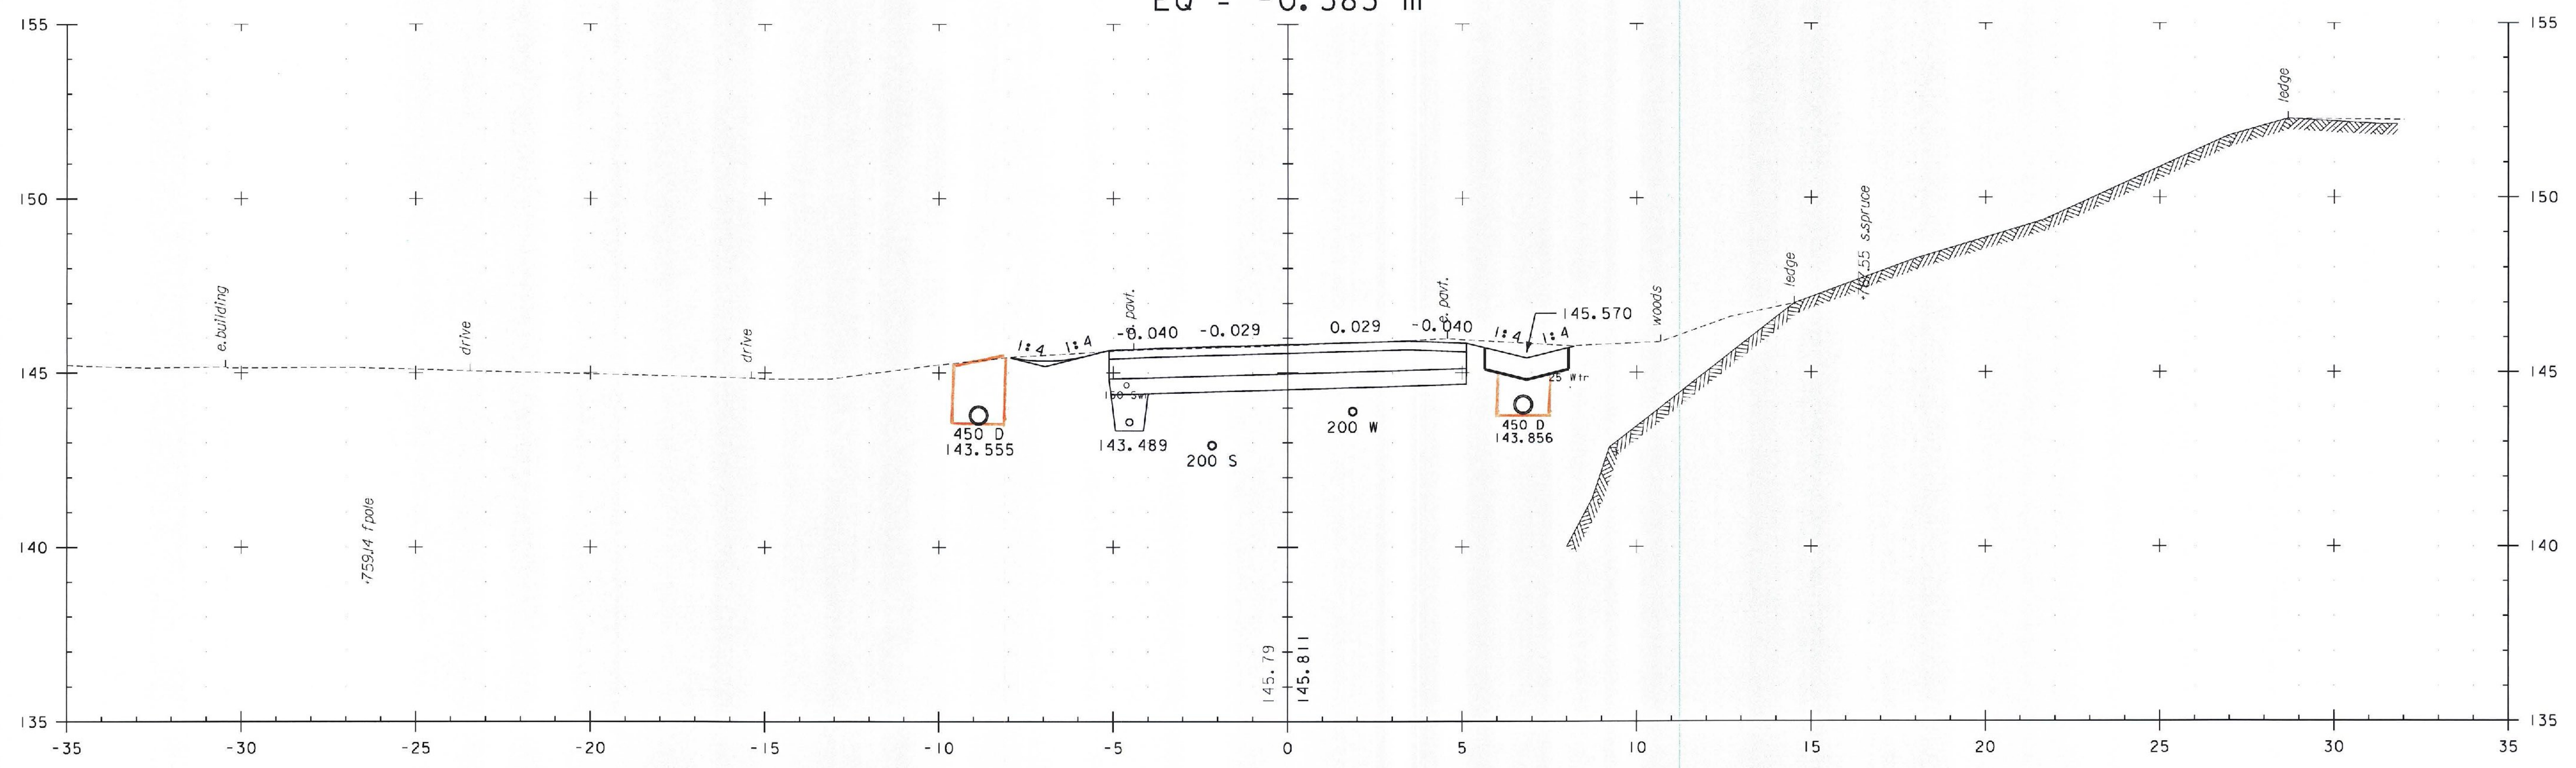

20+760.0

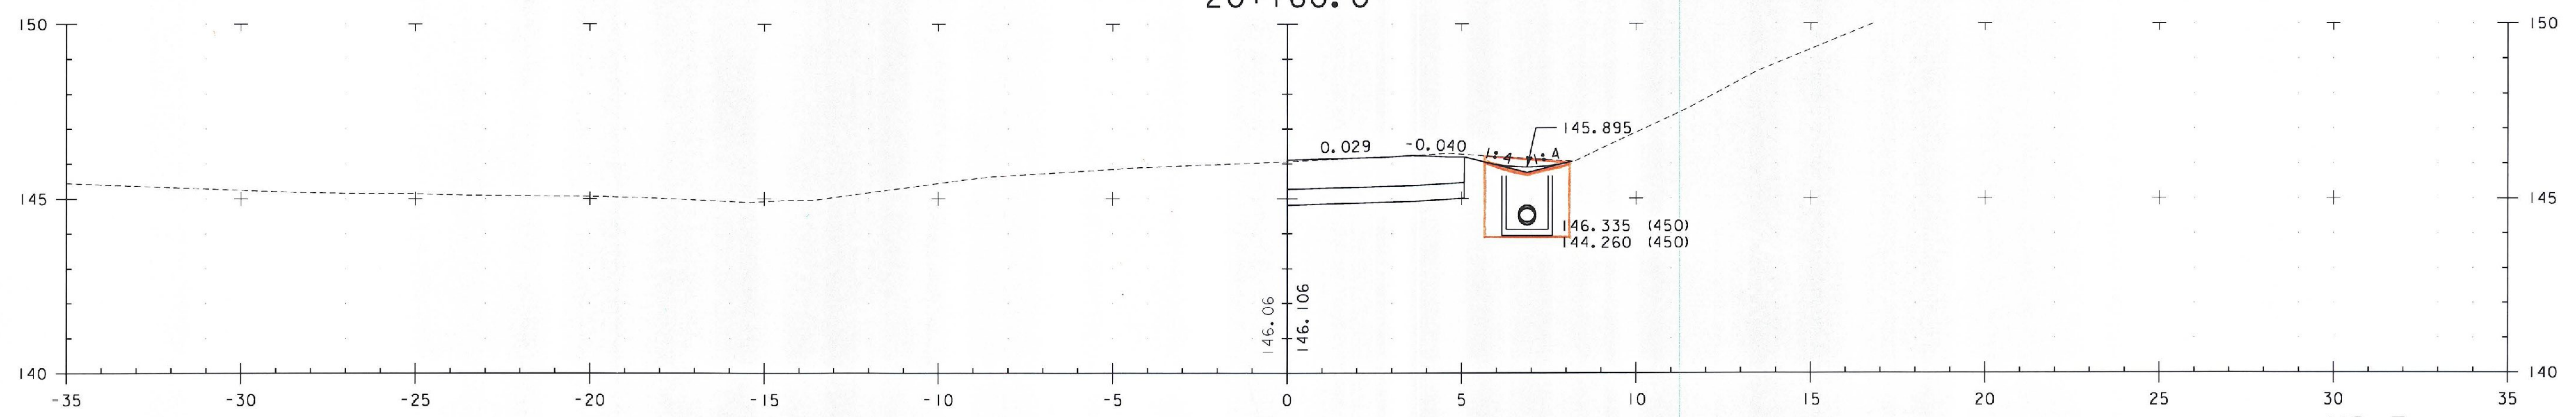

20+755.0

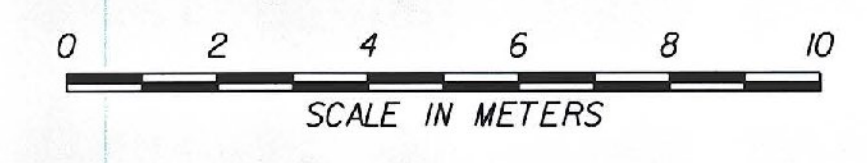

PROJECT NAME:	BRANDON	PLOT DATE:	9/3/2009
PROJECT NUMBER:	NH 019-3(495)	DRAWN BY:	NLL
FILE NAME:	zb008s5-xs270.dgn	CHECKED BY:	DAM
PROJECT LEADER:	CRB	DESIGNED BY:	PTS
CLD 02-0149		SHEET	541 OF 546