



176+81 US 7  
NORTHBOUND LANES

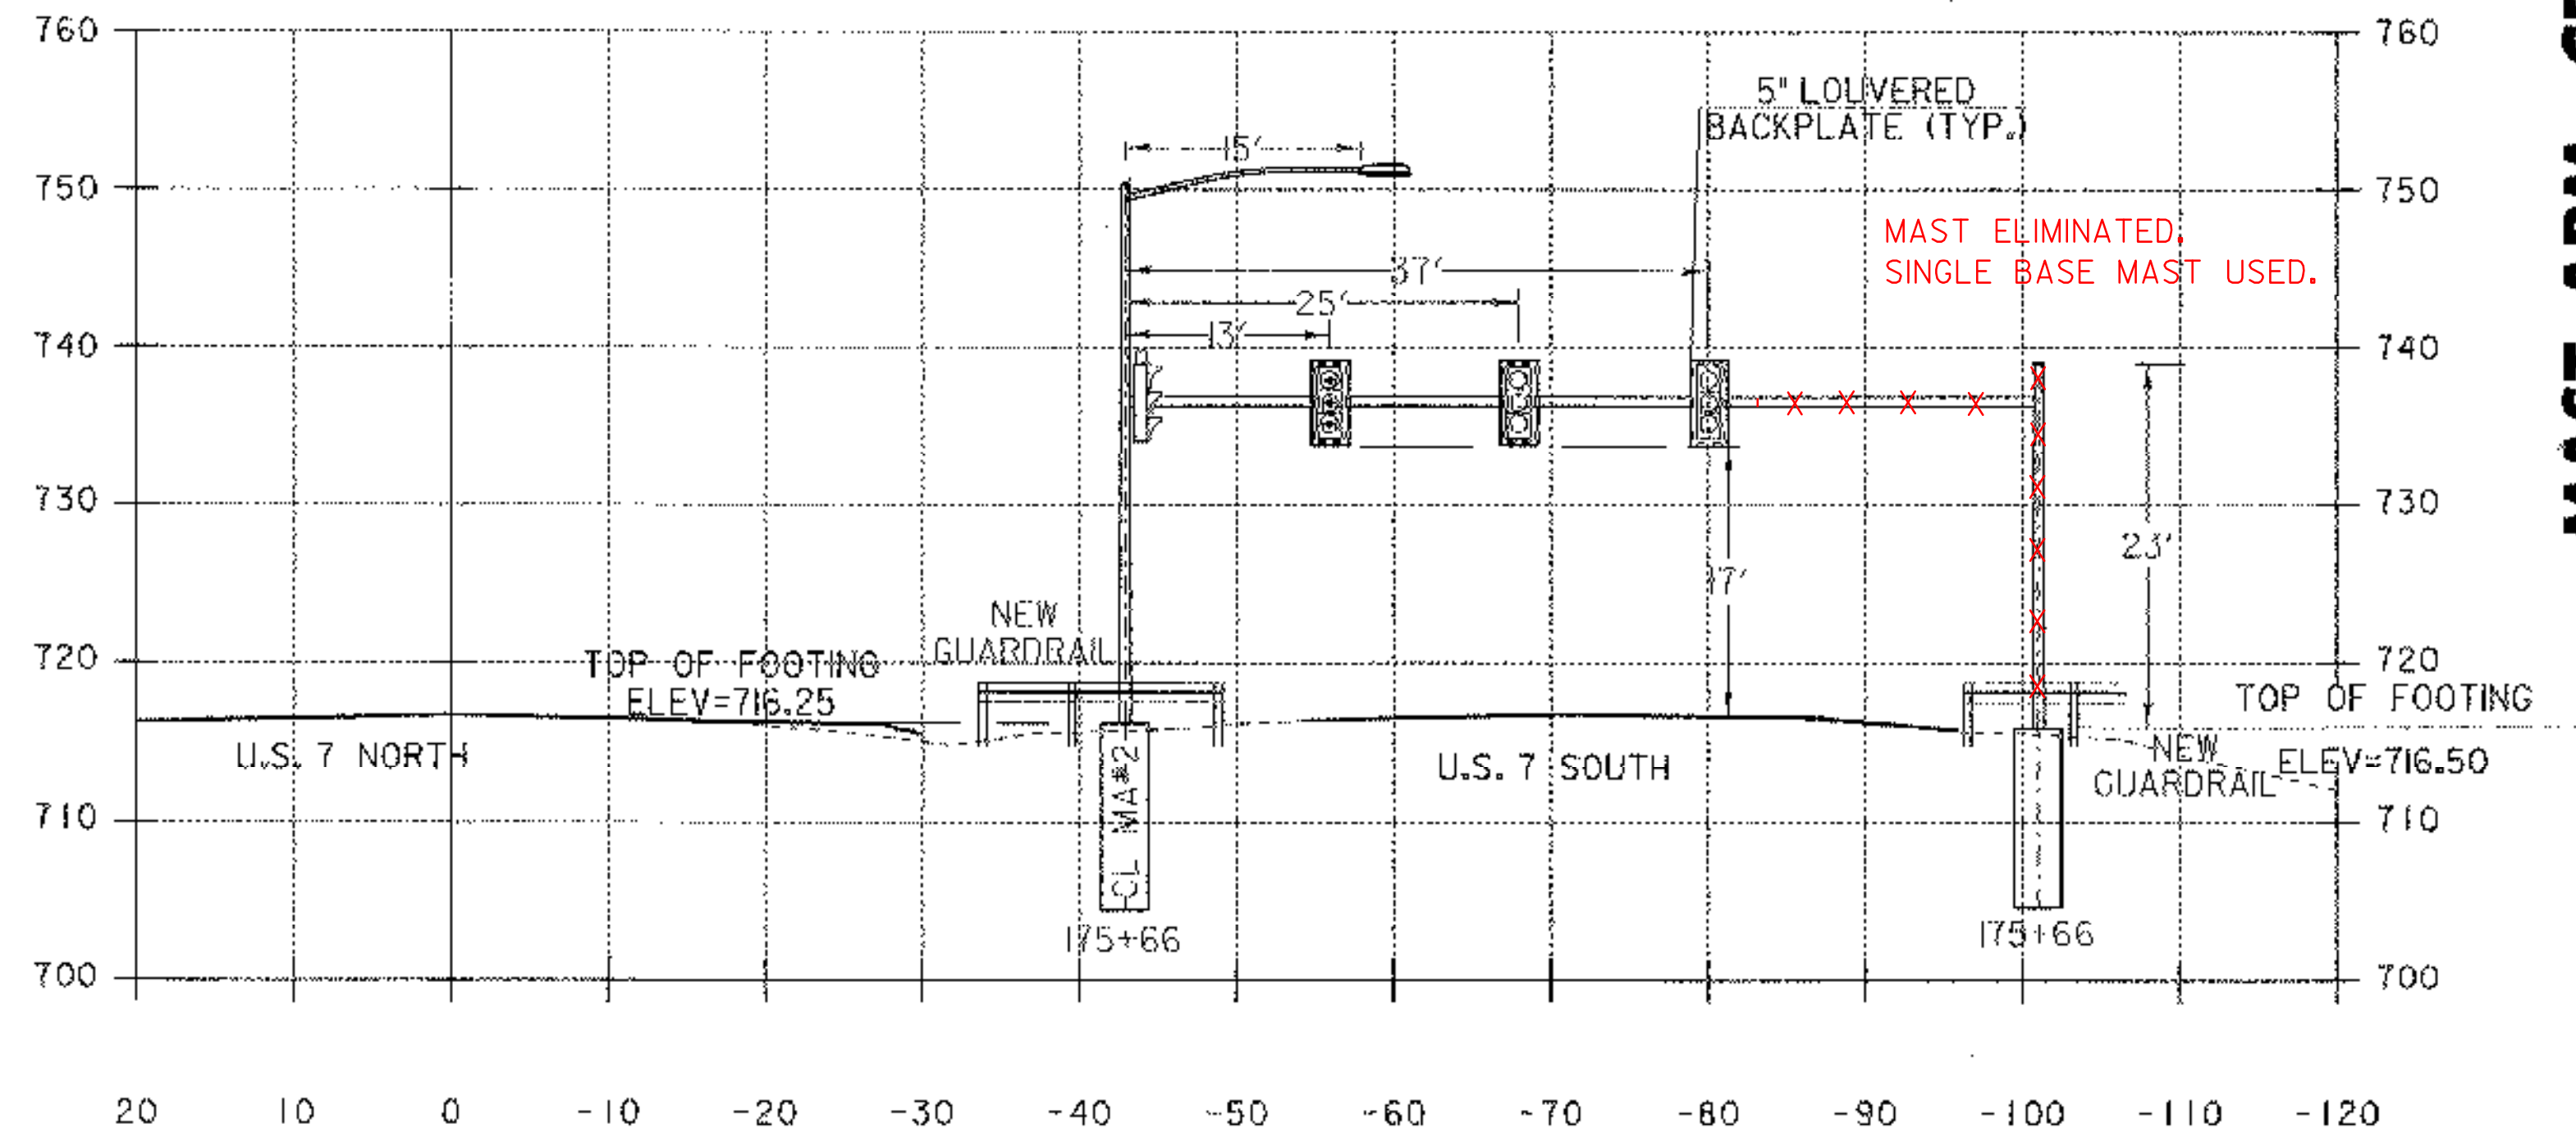

175+66 US 7  
SOUTHBOUND LANES

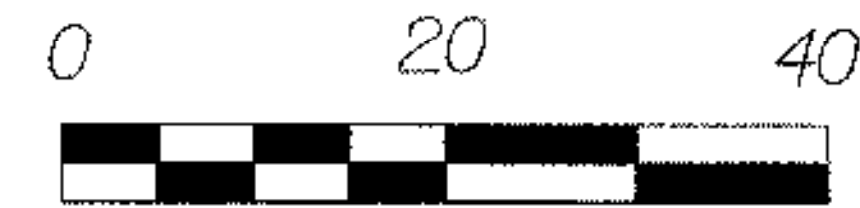

SCALE  
IN FEET  
HORIZ & VERT

PROJECT NAME:	CLARENDON	FILE NAME:	/traf/02b240/tb240slg.dgn	PLOT DATE:	01-NOV-2004
PROJECT NUMBER:	SGNL 024	PROJECT LEADER:	nyquist	DRAWN BY:	JFG
DESIGNED BY:		CHECKED BY:		SHEET	14 OF 37
			/traf/02b240/tb240xml1		