


CLARENDON NHG SGNL (2A)
 WRITE ORDER #11 ATTACHMENT

STOP BAR
 NB 175+62.5 LT-RT

| LETTER OR SYMBOL | |
|------------------|------------------|
| NB 7 | 172+54 LT "ONLY" |
| NB 7 | 173+13 LT |
| NB 7 | 173+74 LT "ONLY" |
| NB 7 | 174+33 LT |
| NB 7 | 174+94 LT "ONLY" |
| NB 7 | 175+53 LT |
| NB 7 | 172+54 RT "ONLY" |
| NB 7 | 173+13 RT |
| NB 7 | 173+74 RT "ONLY" |
| NB 7 | 174+33 RT |
| NB 7 | 174+86 RT "ONLY" |
| NB 7 | 175+41 RT |

4" WHITE LINE
 NB 7 172+50 - 175+00 RT (SOLID)
 NB 7 172+50 - 175+62.5 LT (SOLID)

Changes Per WO #11
 09-07-03
 (70)

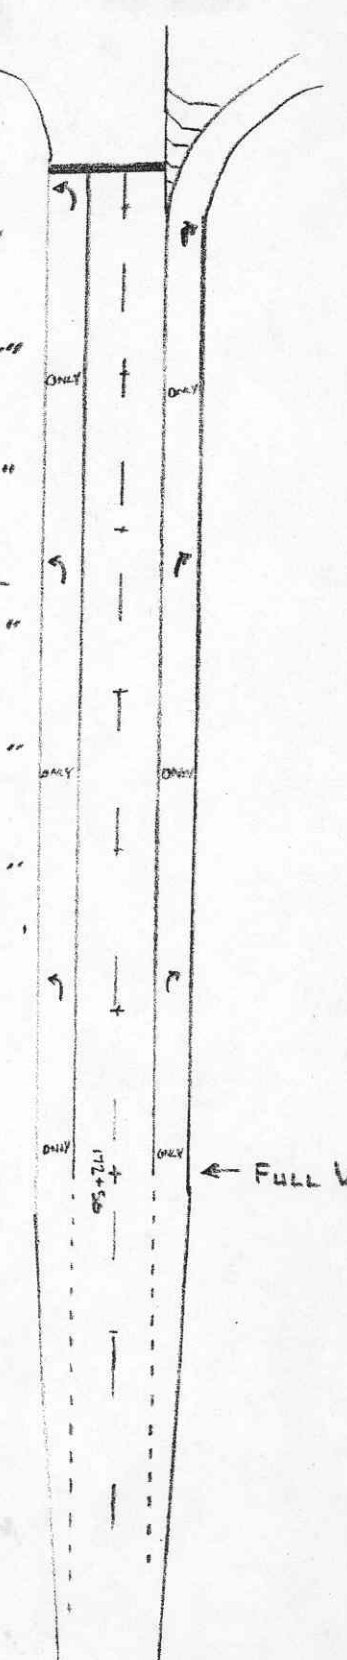

← FULL WIDTH LANE AT 172+50 RT & LT