


TRAFFIC PAVEMENT MARKINGS

Change Per
WO #11 (P) 09-07-05

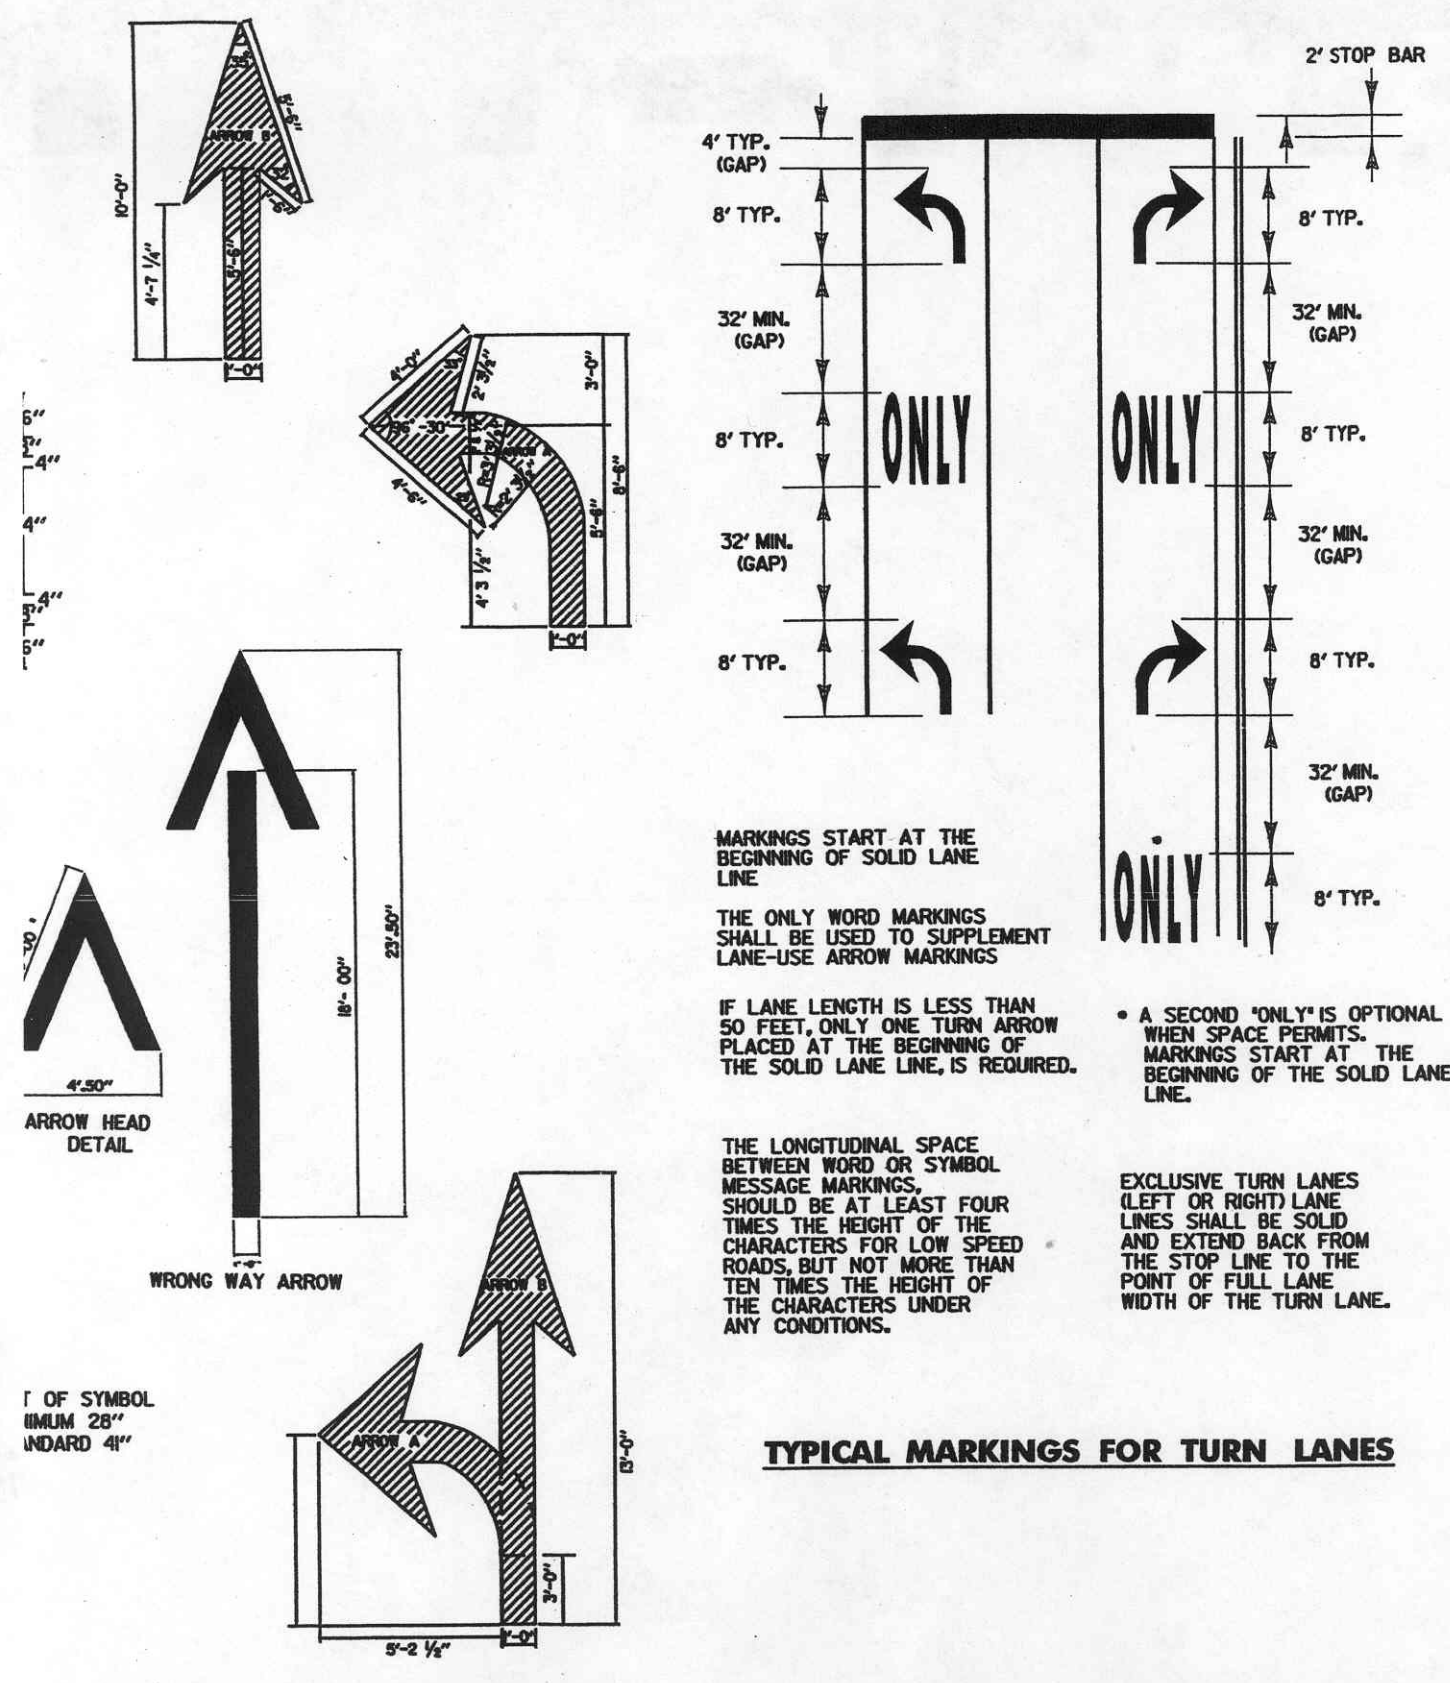

MARKINGS START AT THE BEGINNING OF SOLID LANE LINE.

THE ONLY WORD MARKINGS SHALL BE USED TO SUPPLEMENT LANE-USE ARROW MARKINGS.

IF LANE LENGTH IS LESS THAN 50 FEET, ONLY ONE TURN ARROW PLACED AT THE BEGINNING OF THE SOLID LANE LINE IS REQUIRED.

THE LONGITUDINAL SPACE BETWEEN WORD OR SYMBOL MESSAGE MARKINGS SHOULD BE AT LEAST FOUR TIMES THE HEIGHT OF THE CHARACTERS FOR LOW SPEED ROADS, BUT NOT MORE THAN TEN TIMES THE HEIGHT OF THE CHARACTERS UNDER ANY CONDITIONS.

EXCLUSIVE TURN LANES (LEFT OR RIGHT) LANE LINES SHALL BE SOLID AND EXTEND BACK FROM THE STOP LINE TO THE FRONT OF FULL LANE WIDTH OF THE TURN LANE.

* A SECOND "ONLY" IS OPTIONAL WHEN SPACE PERMITS. MARKINGS START AT THE BEGINNING OF THE SOLID LANE LINE.

TYPICAL MARKINGS FOR TURN LANES