
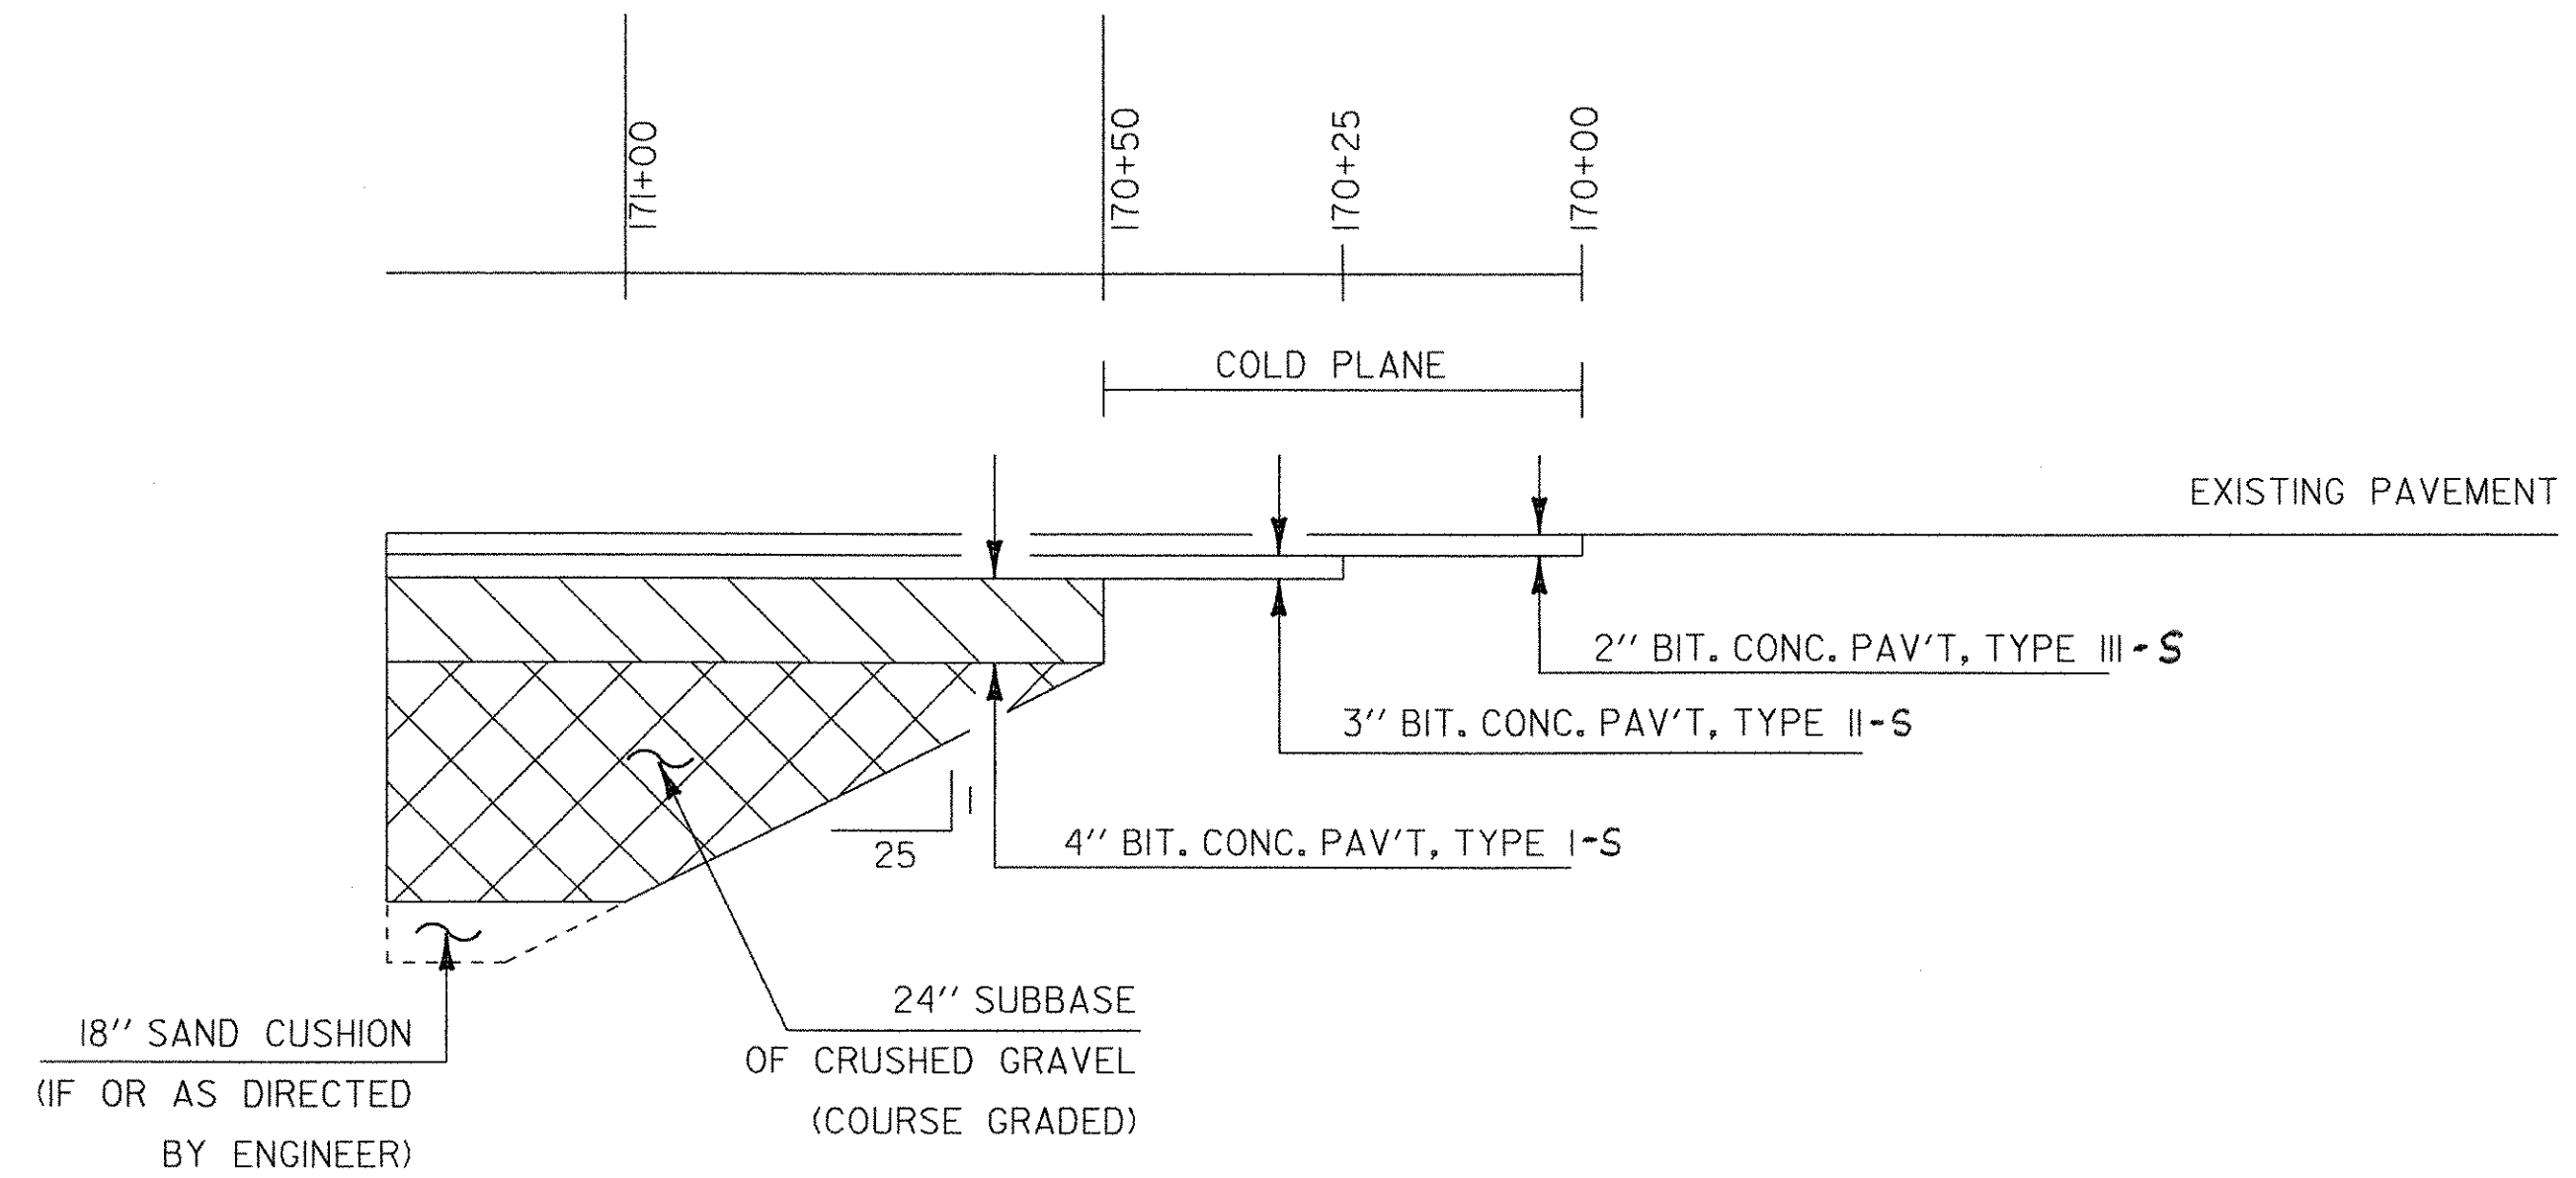


MATERIAL TRANSITION DIAGRAM

FOR SHOULDERS AND TURNING LANES

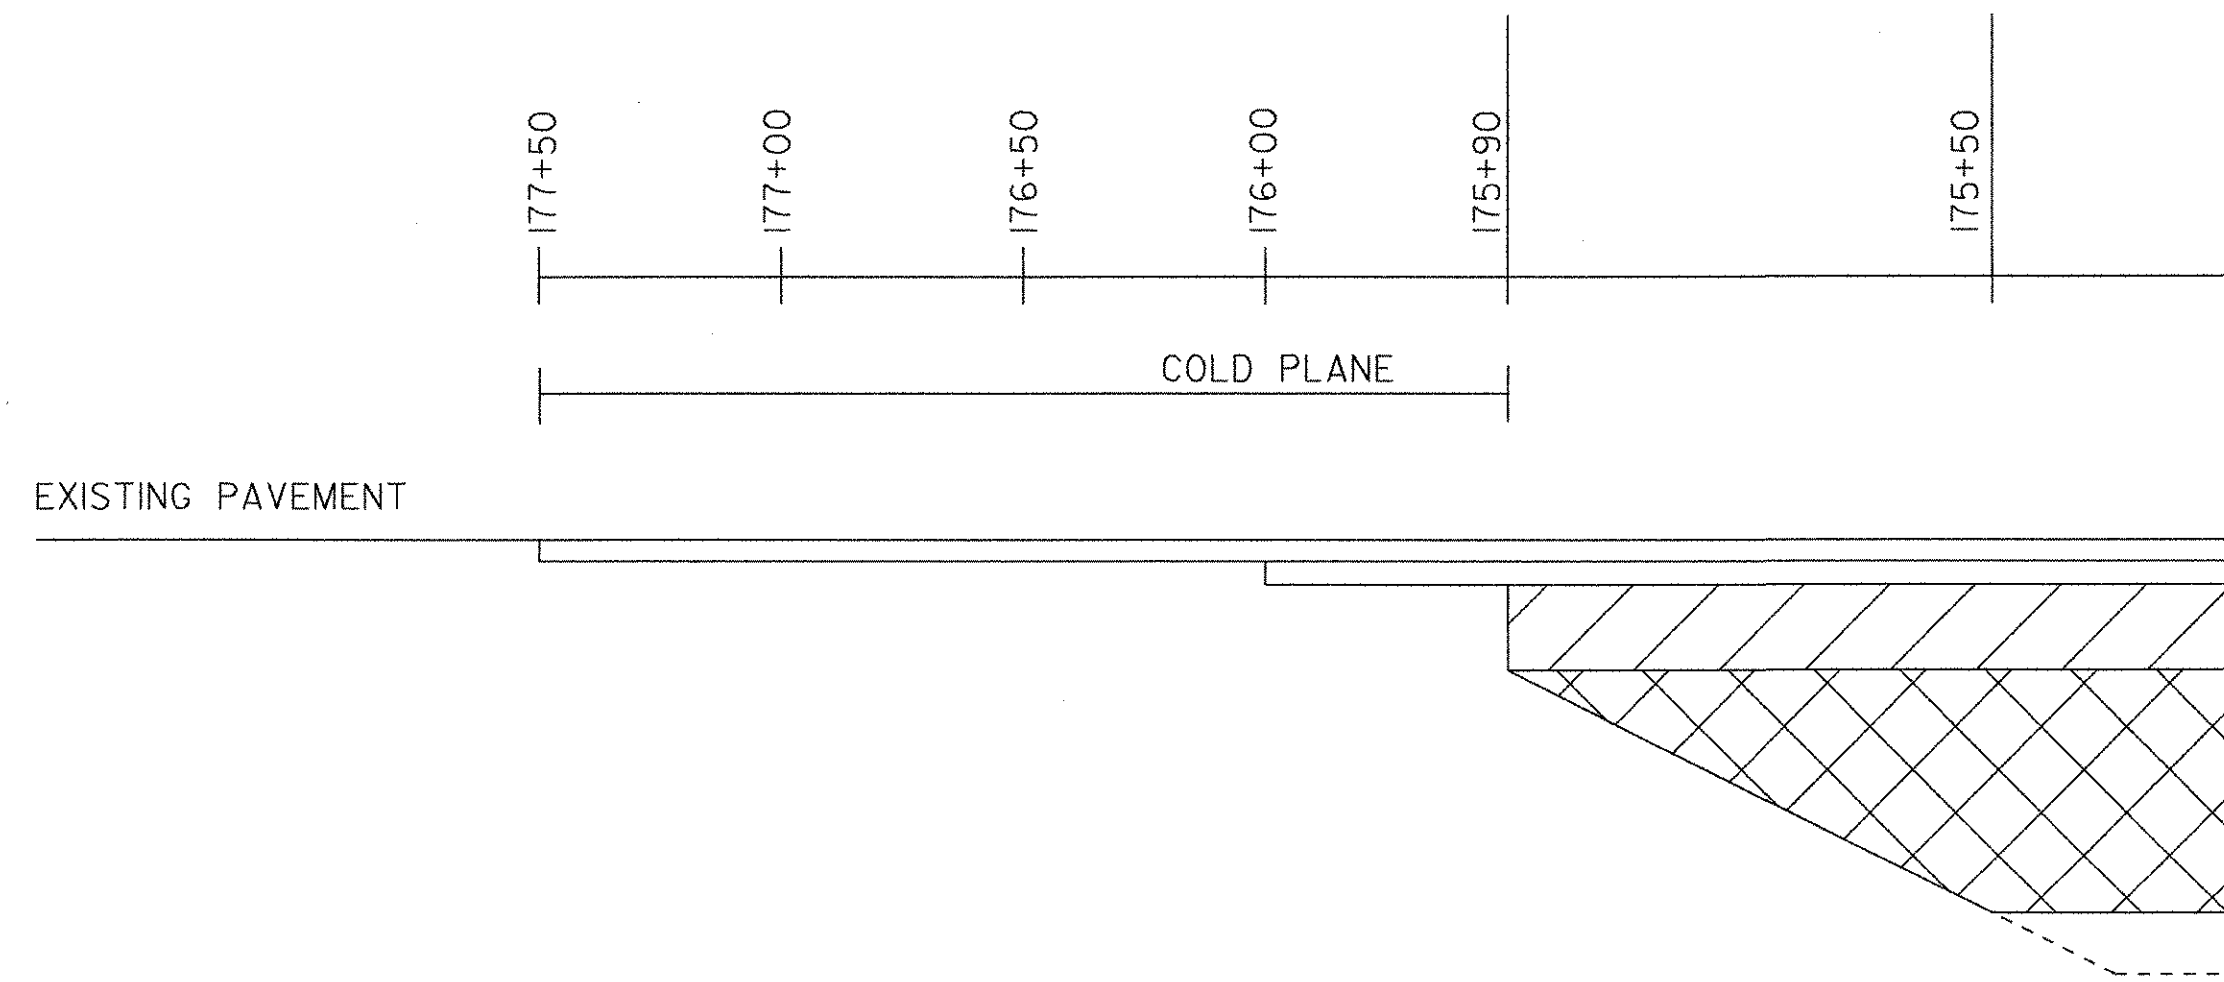

US 7

MATERIAL TRANSITION DIAGRAM

NOT TO SCALE

PROJECT NAME:	CLARENDON	FILE NAME:	02b240/traffic/tb240slg.dgn	PLOT DATE:	06-AUG-2004
PROJECT NUMBER:	NHG SGNL (24)	PROJECT LEADER:	Nyquist	DRAWN BY:	JFG
DESIGNED BY:	JFG	CHECKED BY:	JFG	SHEET	24 OF 37
		tb240mtd.i			

Scan - mgt