

- EXCAVATED PAVEMENT BEING HAULED TO PIKE - DANBY PLANT FOR RECYCLING 07-12-05
- GOOD EXCAVATED SUBBASE BEING HAULED TO DISTRICT #3 STOCKPILE AREA AT AIRPORT FOR THEIR FUTURE USE 07-12-05



**SEEDING FORMULA
RURAL AREAS**

% WT.	LBS./A.	NAME	PLUR %	GERM %
37.5	22.5	CREeping RED FESCUE	98	85
37.5	22.5	TALL FESCUE	95	90
5.0	3.0	RED TOP	95	90
15.0	9.0	BIRDFOOT TREFoil	98	85
5.0	3.0	ANNUAL RYEGRASS	95	85
100.0	60.0			

GENERAL NOTES

SEED MIXTURE: SHALL NOT HAVE A WEED CONTENT EXCEEDING 0.40% BY WEIGHT AND SHALL BE FREE OF ALL NOXIOUS SEED.
 SEED: TO BE APPLIED PER SEEDING FORMULAS OR AS DIRECTED BY THE ENGINEER.
 FERTILIZER: FORMULA 10-20-10, TO BE USED WITH SEED, APPLIED AT THE RATE OF 500 LBS./ACRE. (HYDRO SEEDERS MAY USE 19-19-19 FORMULA).
 AGRICULTURAL LIMESTONE: TO BE APPLIED AT THE RATE OF 2 TONS/ACRE, OR AS DIRECTED BY THE ENGINEER.
 TOPSOIL: TO BE USED WITH SEED AS INDICATED ON THE PLANS, OR AS DIRECTED BY THE ENGINEER.
 SLOPE ROUNDING: ALL CUT SLOPES TO BE ROUNDED IN ACCORDANCE WITH STANDARD SHEET B - 5.

LEGEND

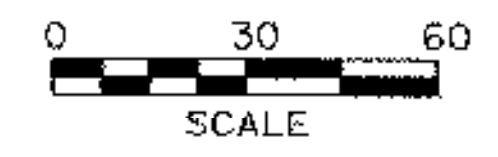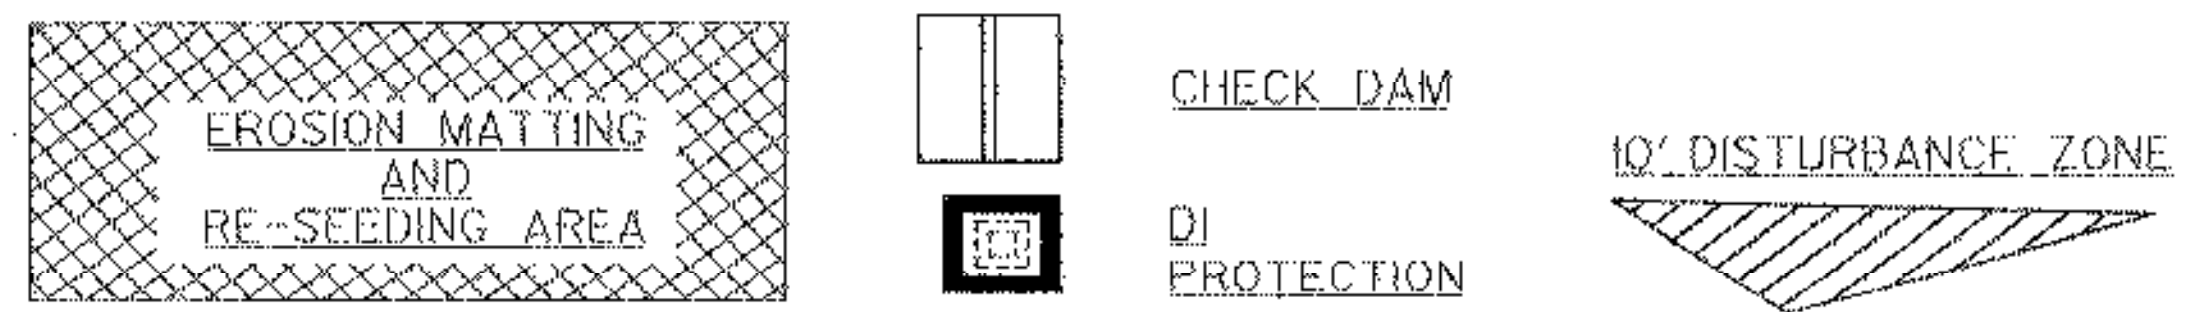

EROSION CONTROL SITE PLAN

PROJECT NAME: CLARENDON	PLOT DATE: 16-FEB-2005
PROJECT NUMBER: NHG SGNL (24)	DRAWN BY: gruchacz
FILE NAME: 02b240/tb240ec.dgn	CHECKED BY:
PROJECT LEADER: ryquief	SHEET 31 OF 37