

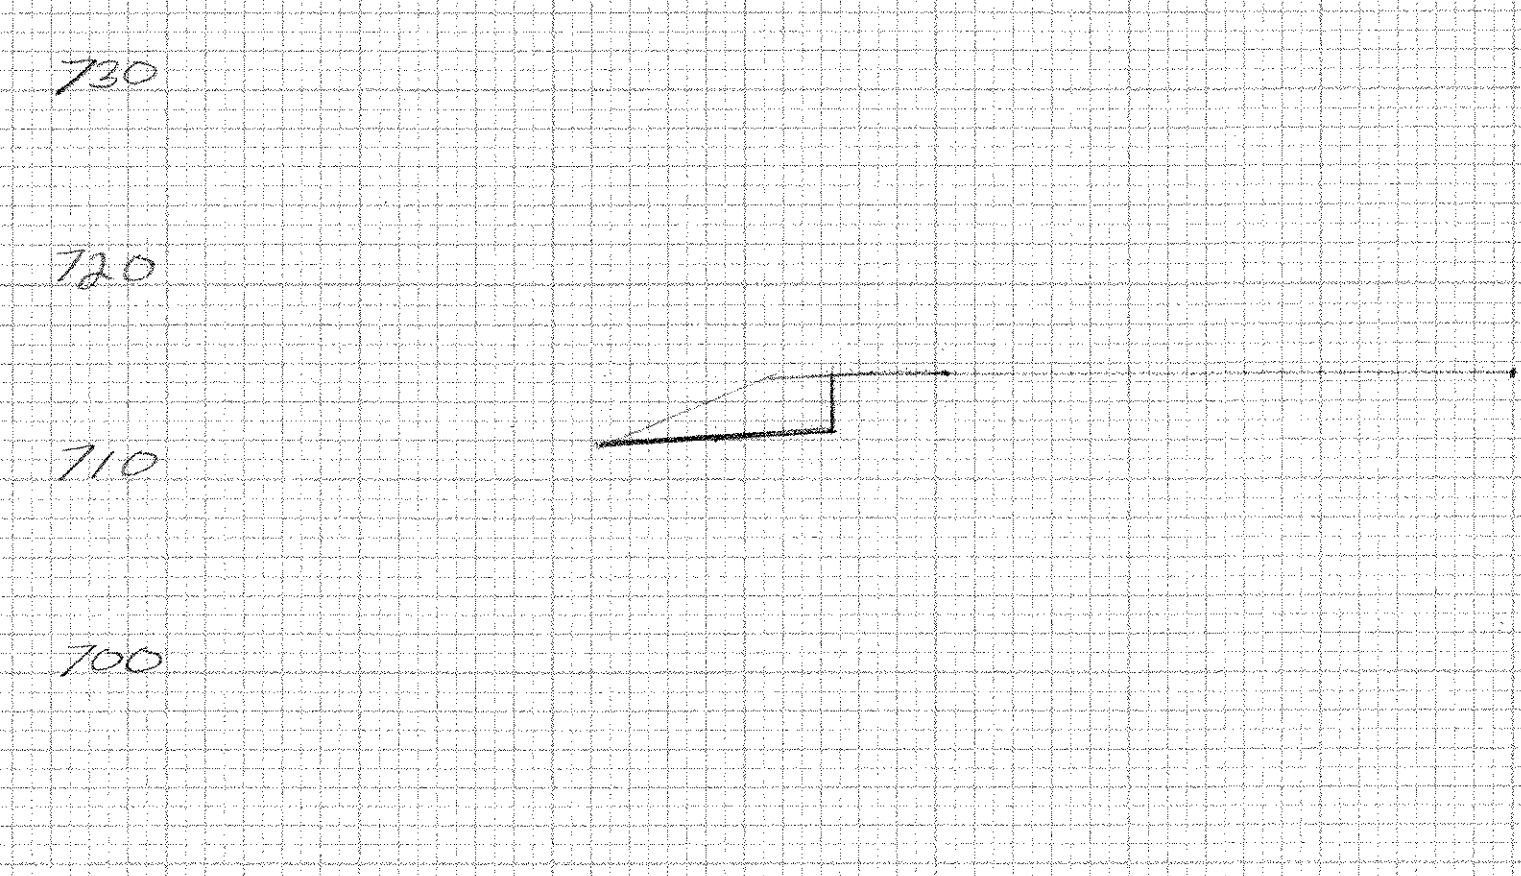
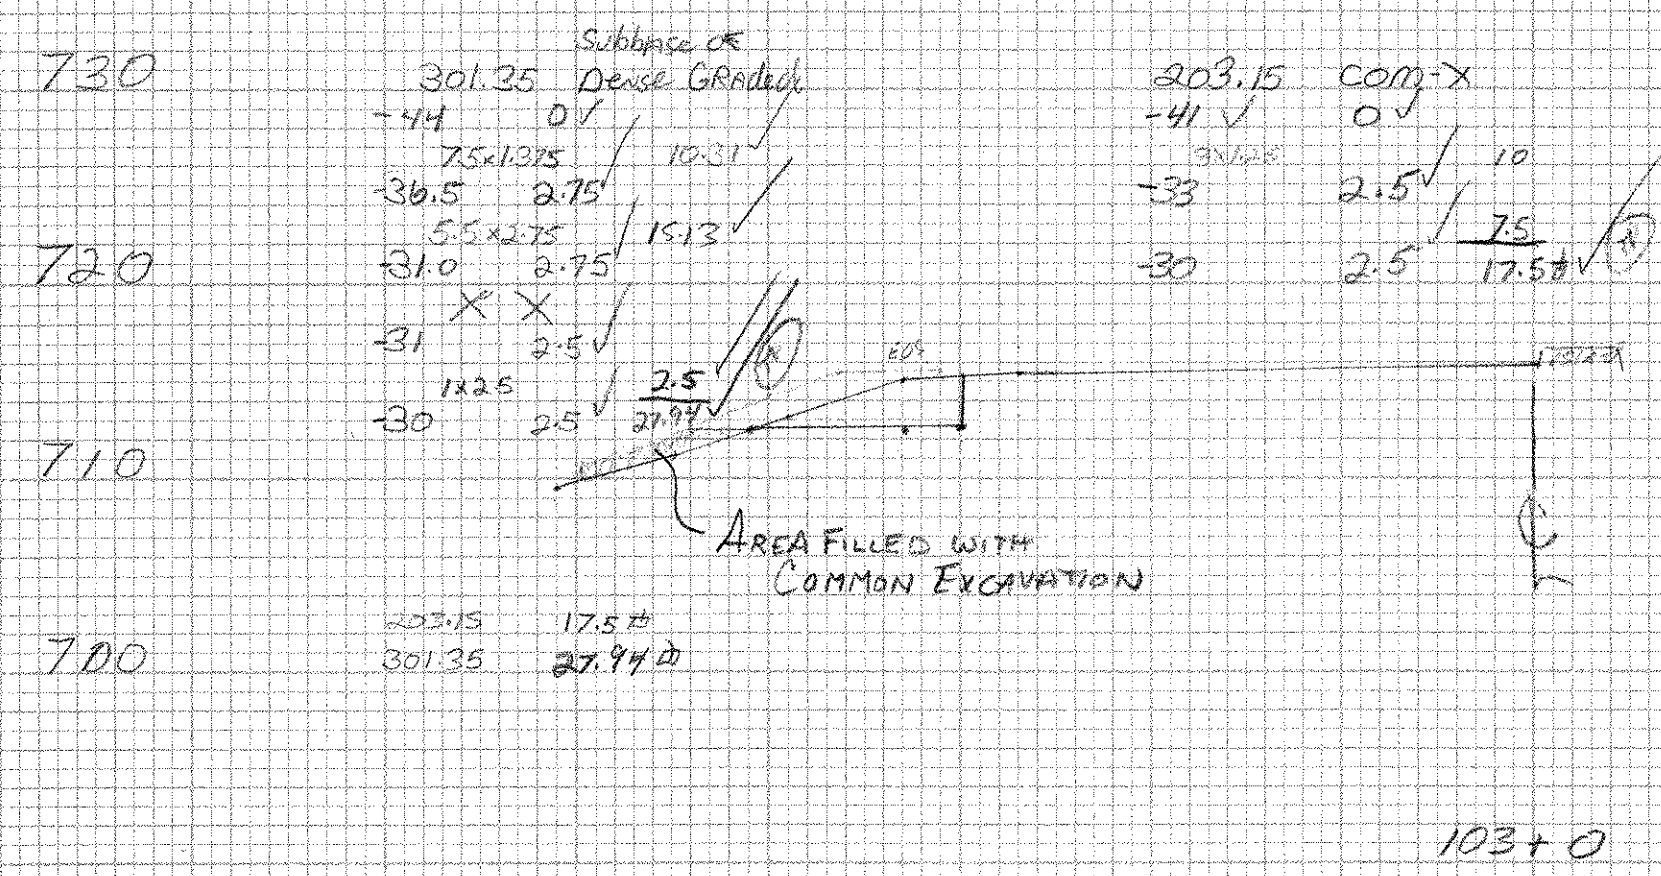


NO. HOLE BOOK NO. DATE  
 NAME SURVEYOR  
 ORIGINAL



NO. HOLE BOOK NO. DATE  
 NAME SURVEYOR  
 ORIGINAL

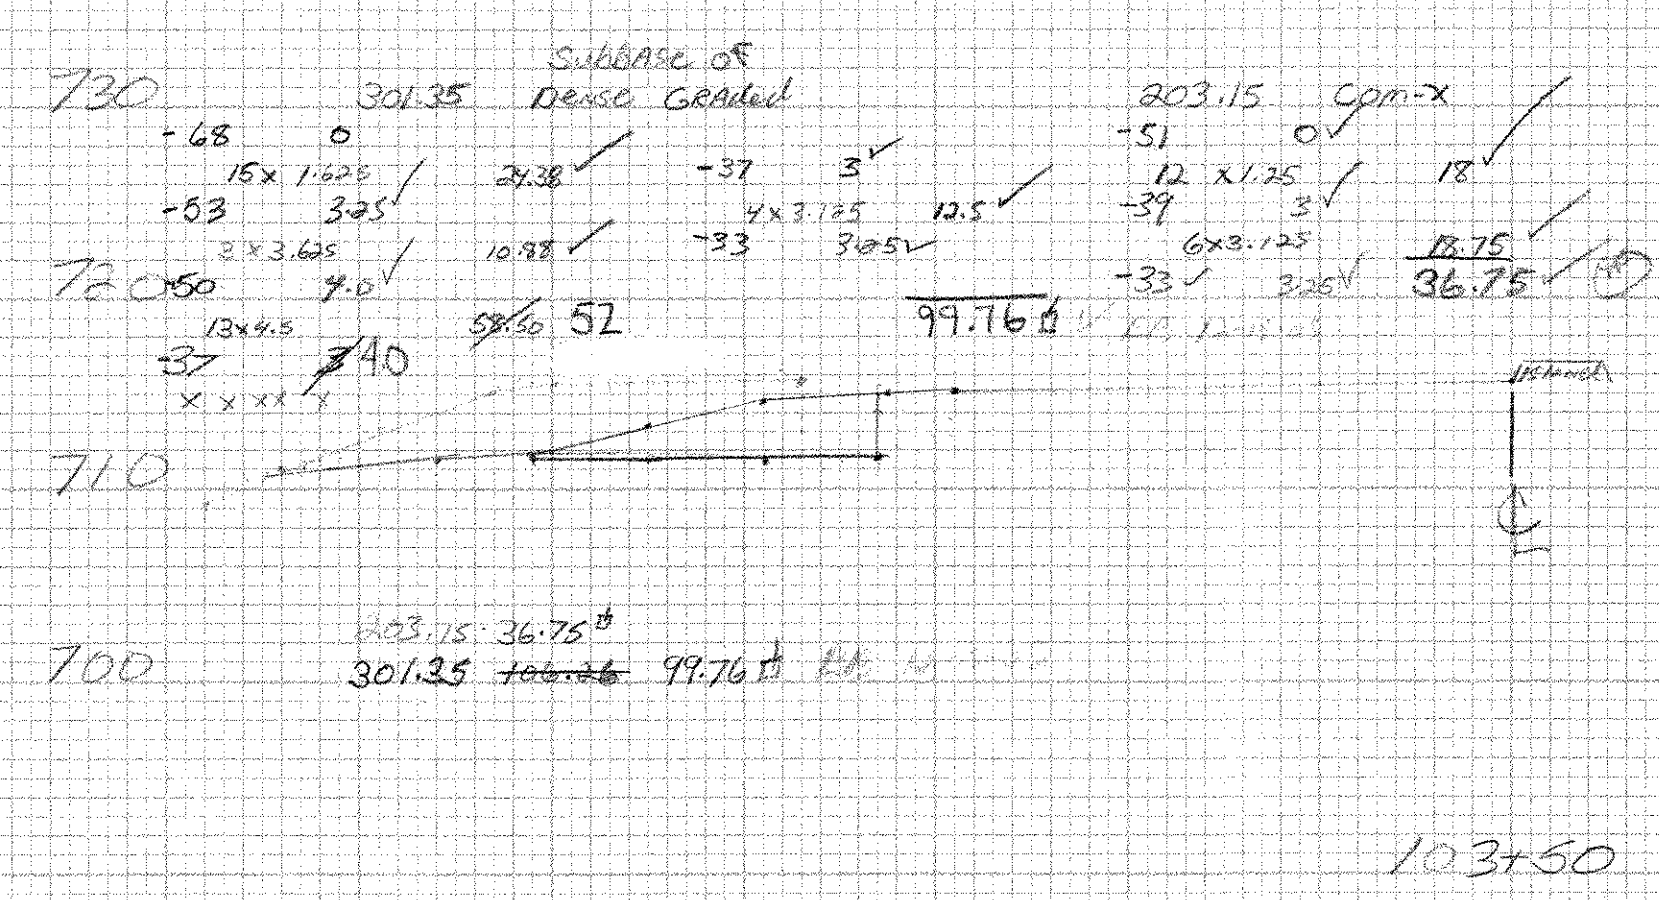

ITEM 203.15 - COMMON EXCAVATION  
 QUANTITIES TO SPREADSHEET FOR  
 CALCULATIONS OF FINAL QUANTITIES.  
 SEE SHEETS 203.15-1 TO 203.15-2  
 OF CALCULATION BINDER FOR DETAILS.

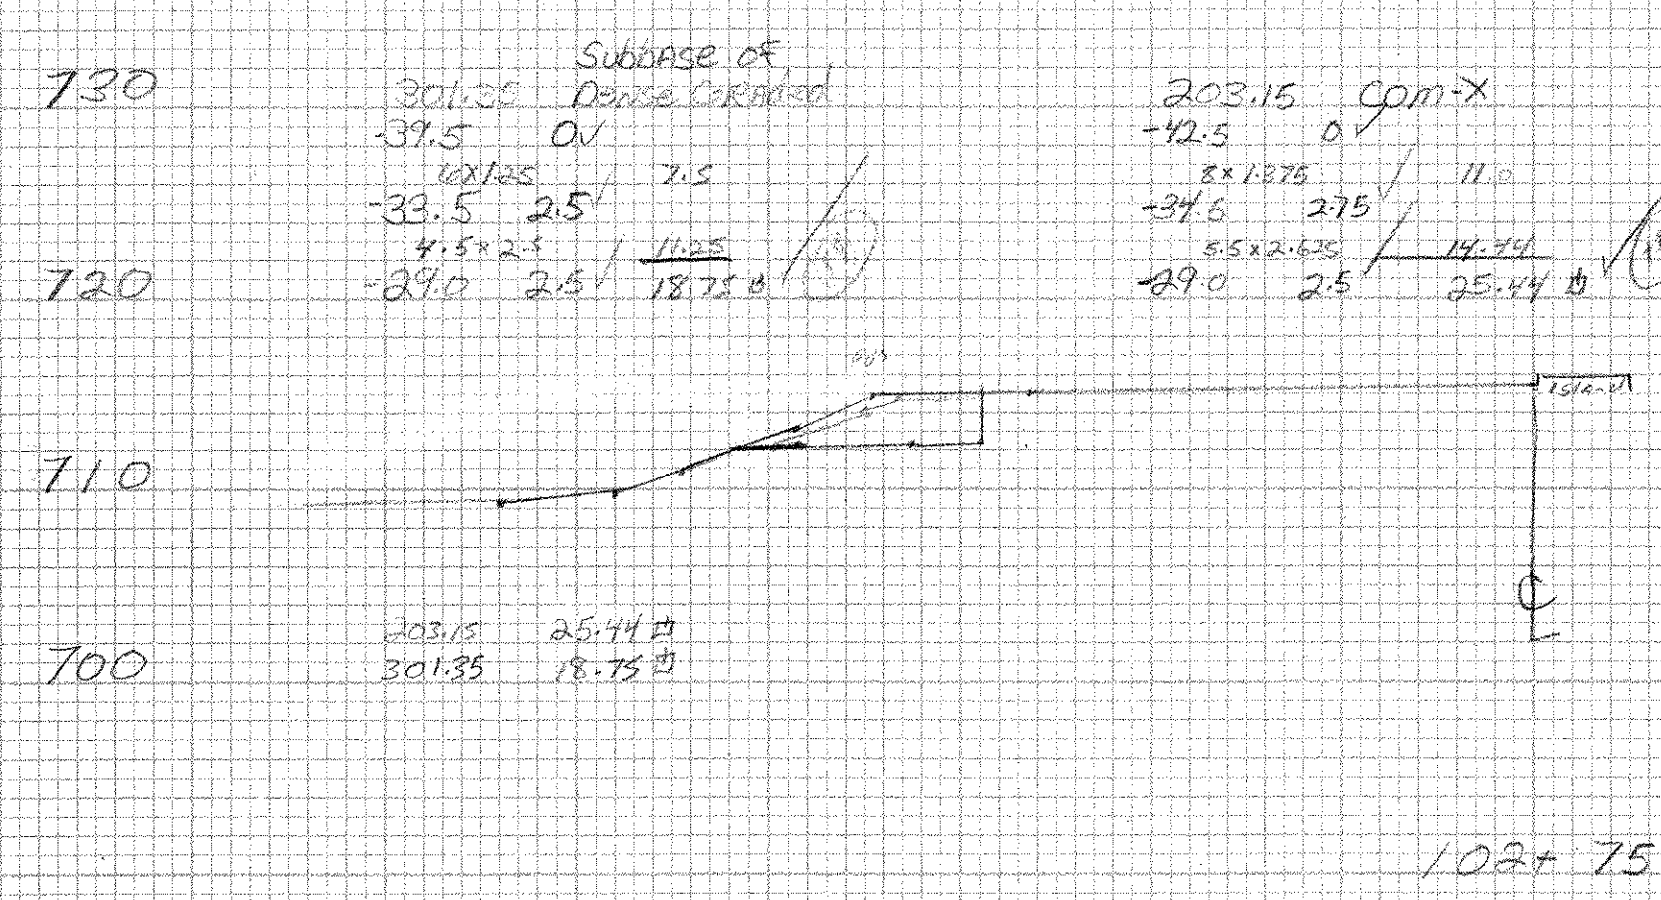

ITEM 301.35 - SUBBASE OF DENSE GRADED  
 CRUSHED STONE  
 QUANTITIES TO SPREADSHEET FOR  
 CALCULATION OF FINAL QUANTITIES  
 SEE SHEETS 301.35-1 TO 301.35-2  
 OF CALCULATION BINDER FOR DETAILS.

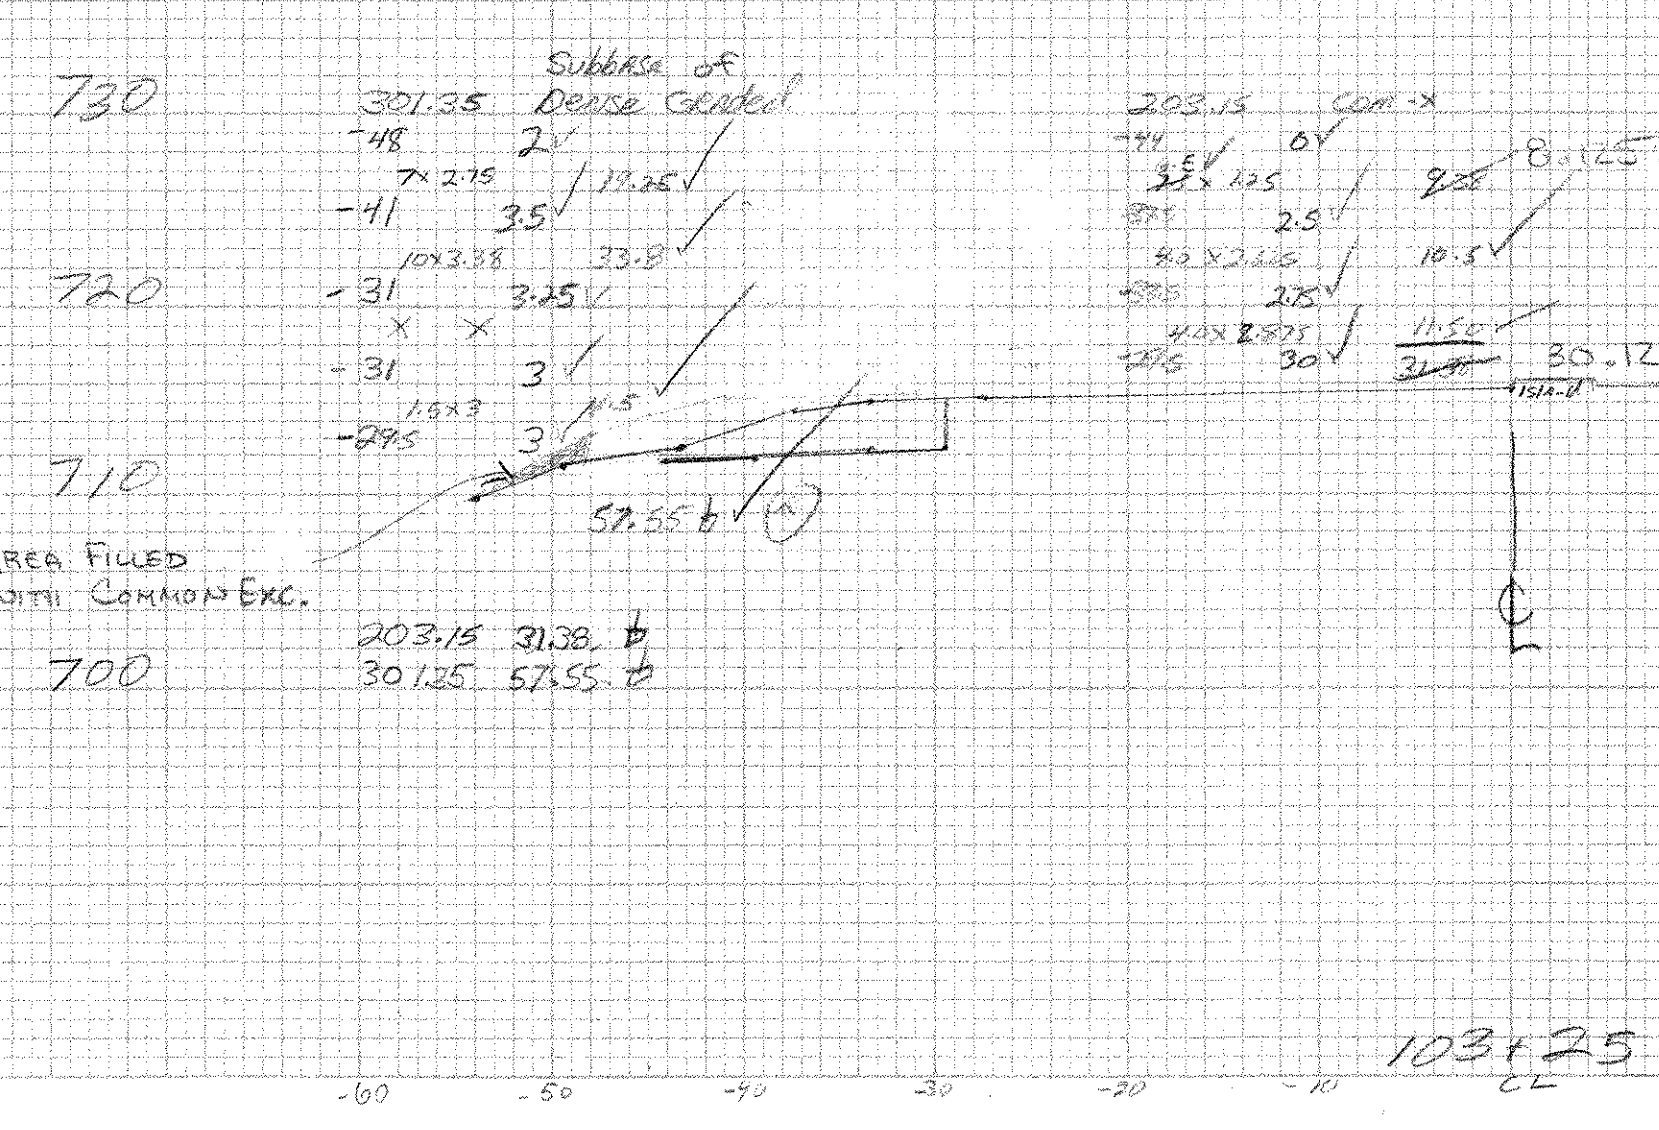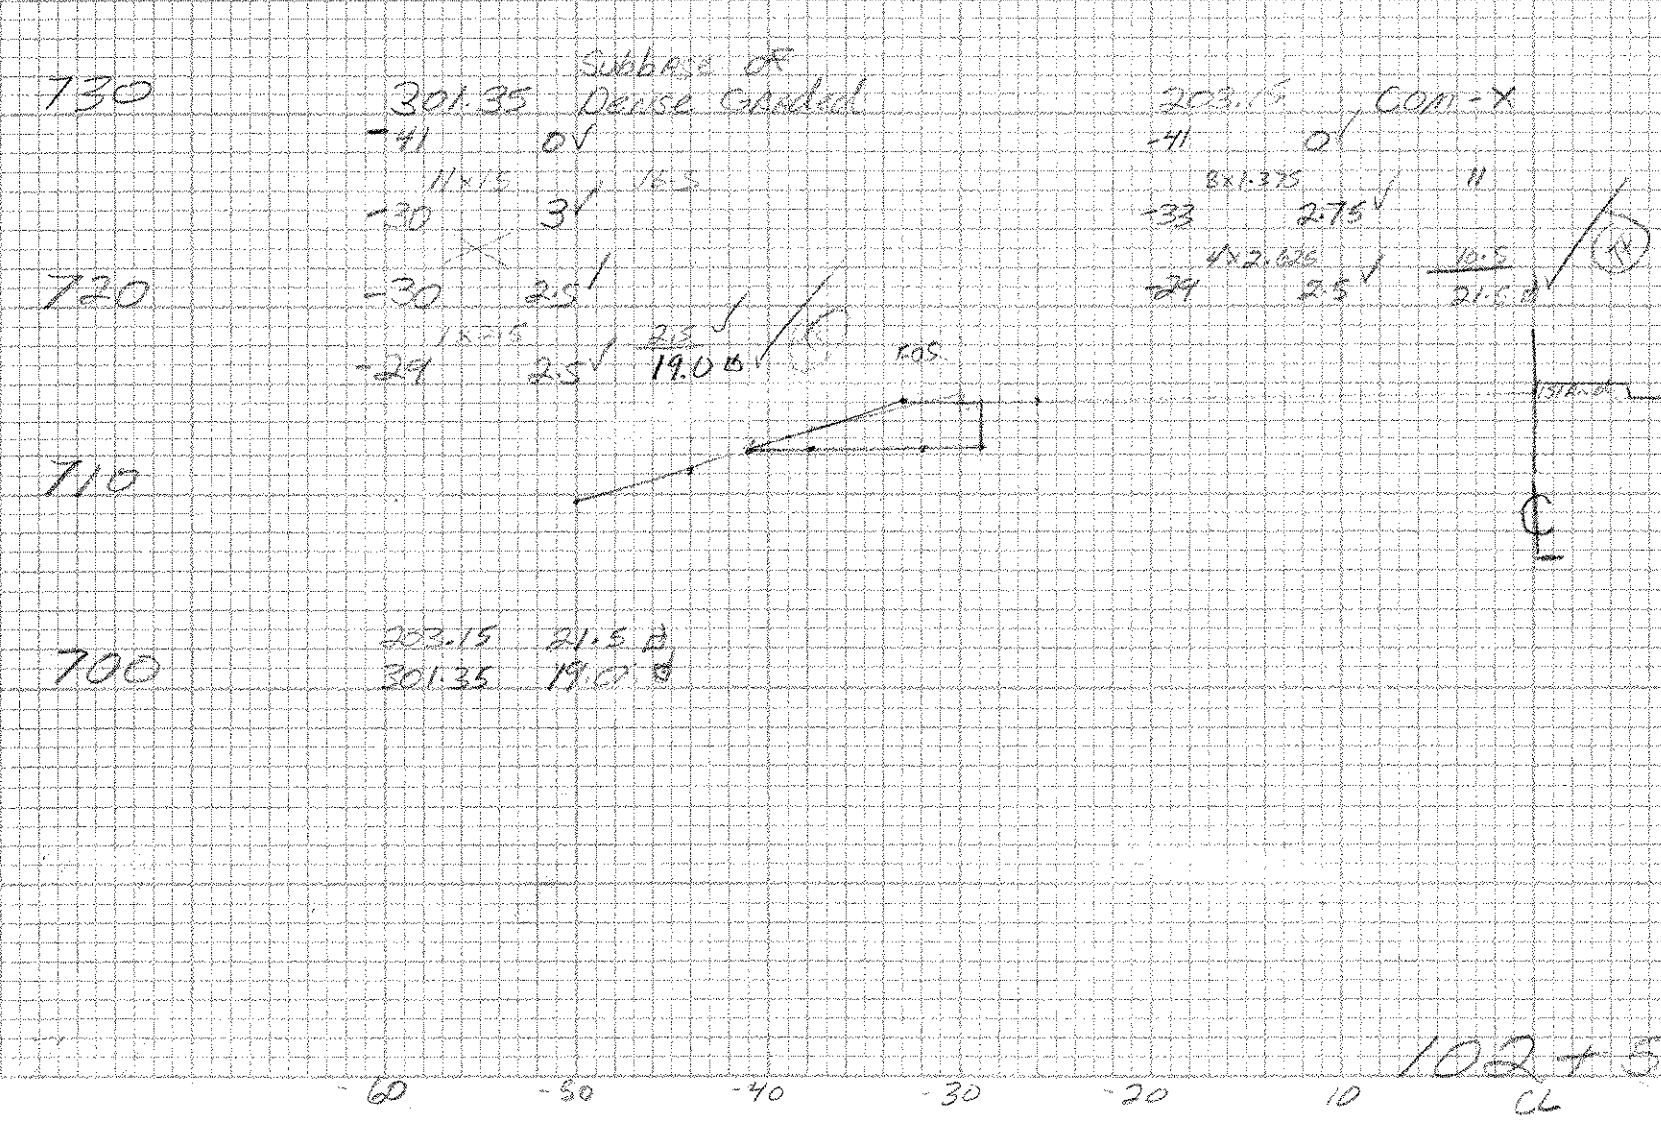

DRAWN BY  
 BRUCE BOYLE  
 CHECKED BY  
 TIM BOYETTE  
 CLARENDON NHG SGNL (24)  
 038