

60 50 40 30 20 10 CL 10 20 30 40 50 60


730

720

710

700

175+75

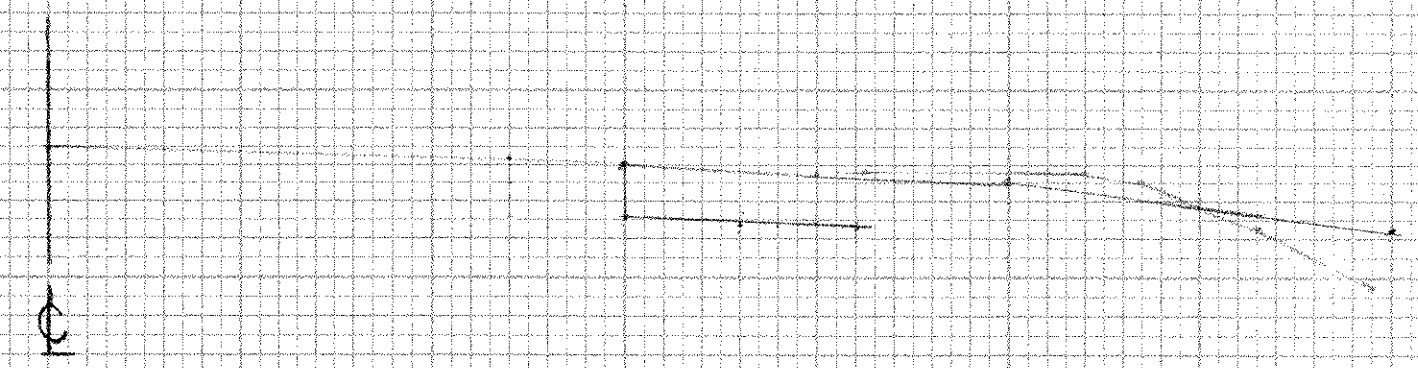

ITEM 203.15 - COMMON EXCAVATION
 QUANTITIES TO SPREADSHEET FOR
 CALCULATION OF FINAL QUANTITIES.
 SEE SHEETS 203.15-1 TO
 203.15-2
 OF CALCULATION BINDER FOR DETAILS. (TP)

ITEM 301.35 - SUBBASE OF DENSE GRADED CRUSHED STONE
 QUANTITIES TO SPREADSHEET FOR
 CALCULATION OF FINAL QUANTITIES.
 SEE SHEETS 301.35-1 TO 301.35-2
 OF CALCULATION BINDER FOR DETAILS. (TP)


730

720

710

700

175+50

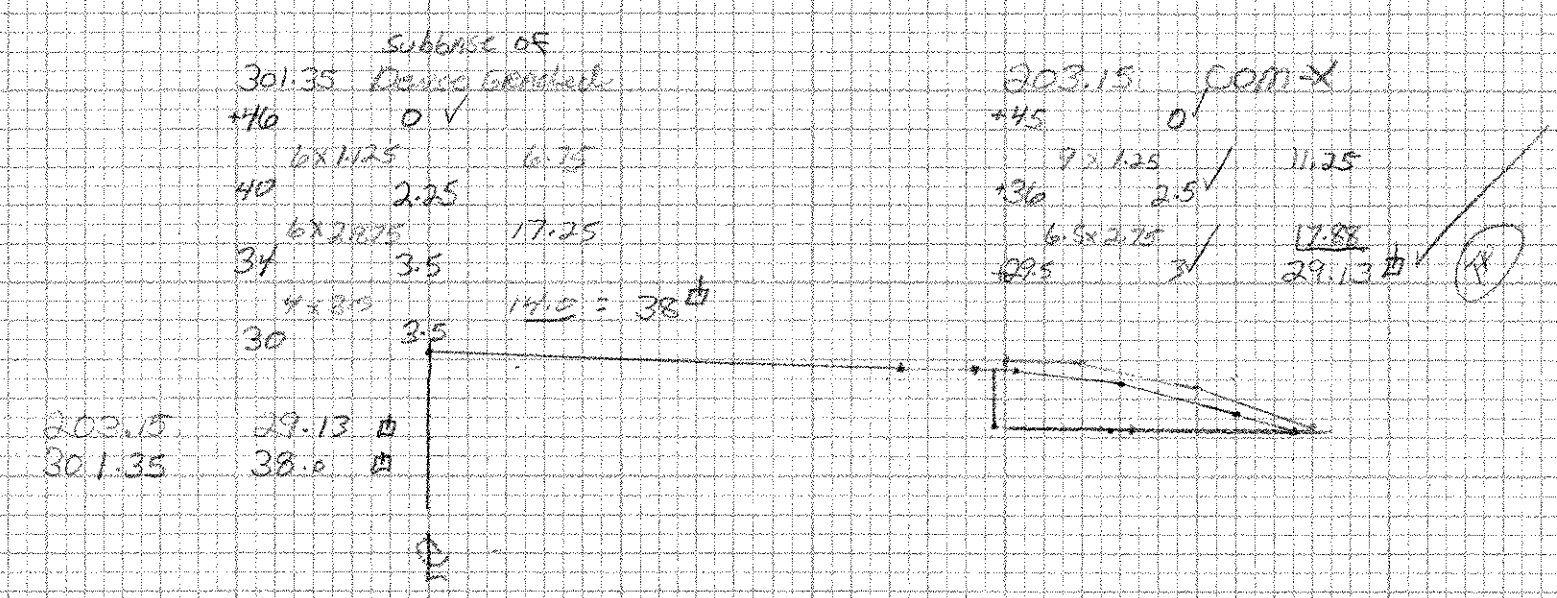

303.15
301.35

29.13 #
38.0 #

303.15 COM-X
 36 2.5 17.88
 225 3 24.13


730

720

710

700

175+22

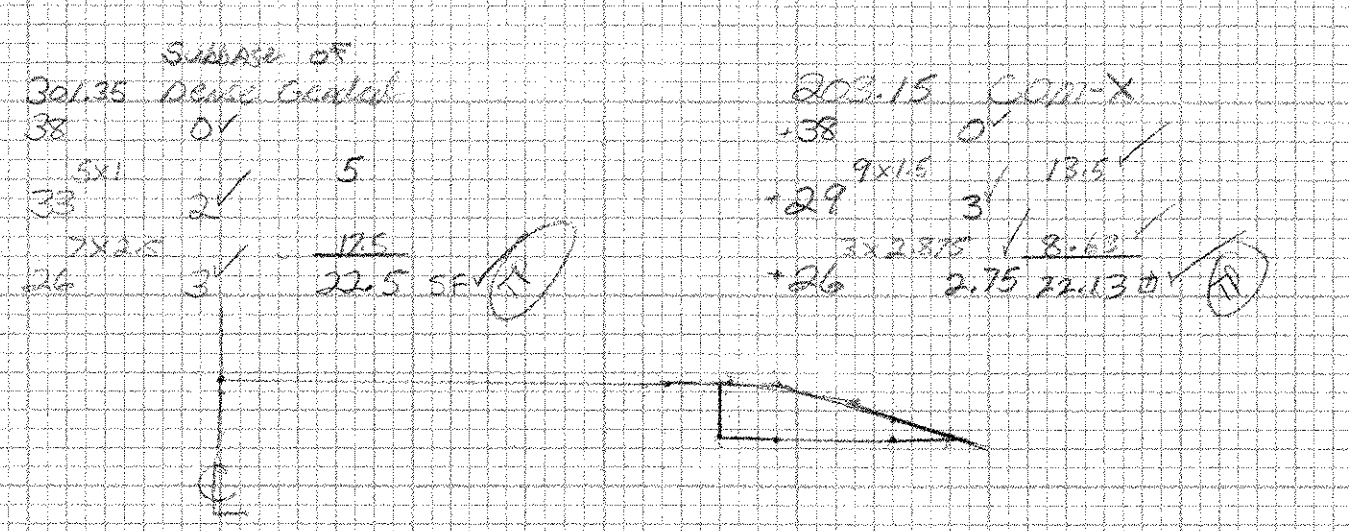

303.15
301.35

29.13 #
22.5 #

303.15 COM-X
 38 0 13.5
 29 3 18.0
 26 2.75 24.13

DRAWN BY BRUCE BOYLE
 CHECKED BY TIM FELKETT
 (TP) 12-13-2005

NO MOLE BOOK
 SHEETS
 ORIGINAL
 DATE

NO MOLE BOOK
 SHEETS
 ORIGINAL
 DATE

-60 -50 -40 -30 -20 -10 0 10 20 30 40 50 60