
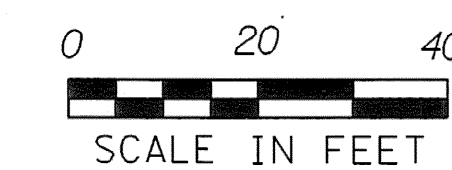


END RECLAIM
STA 313+63.61

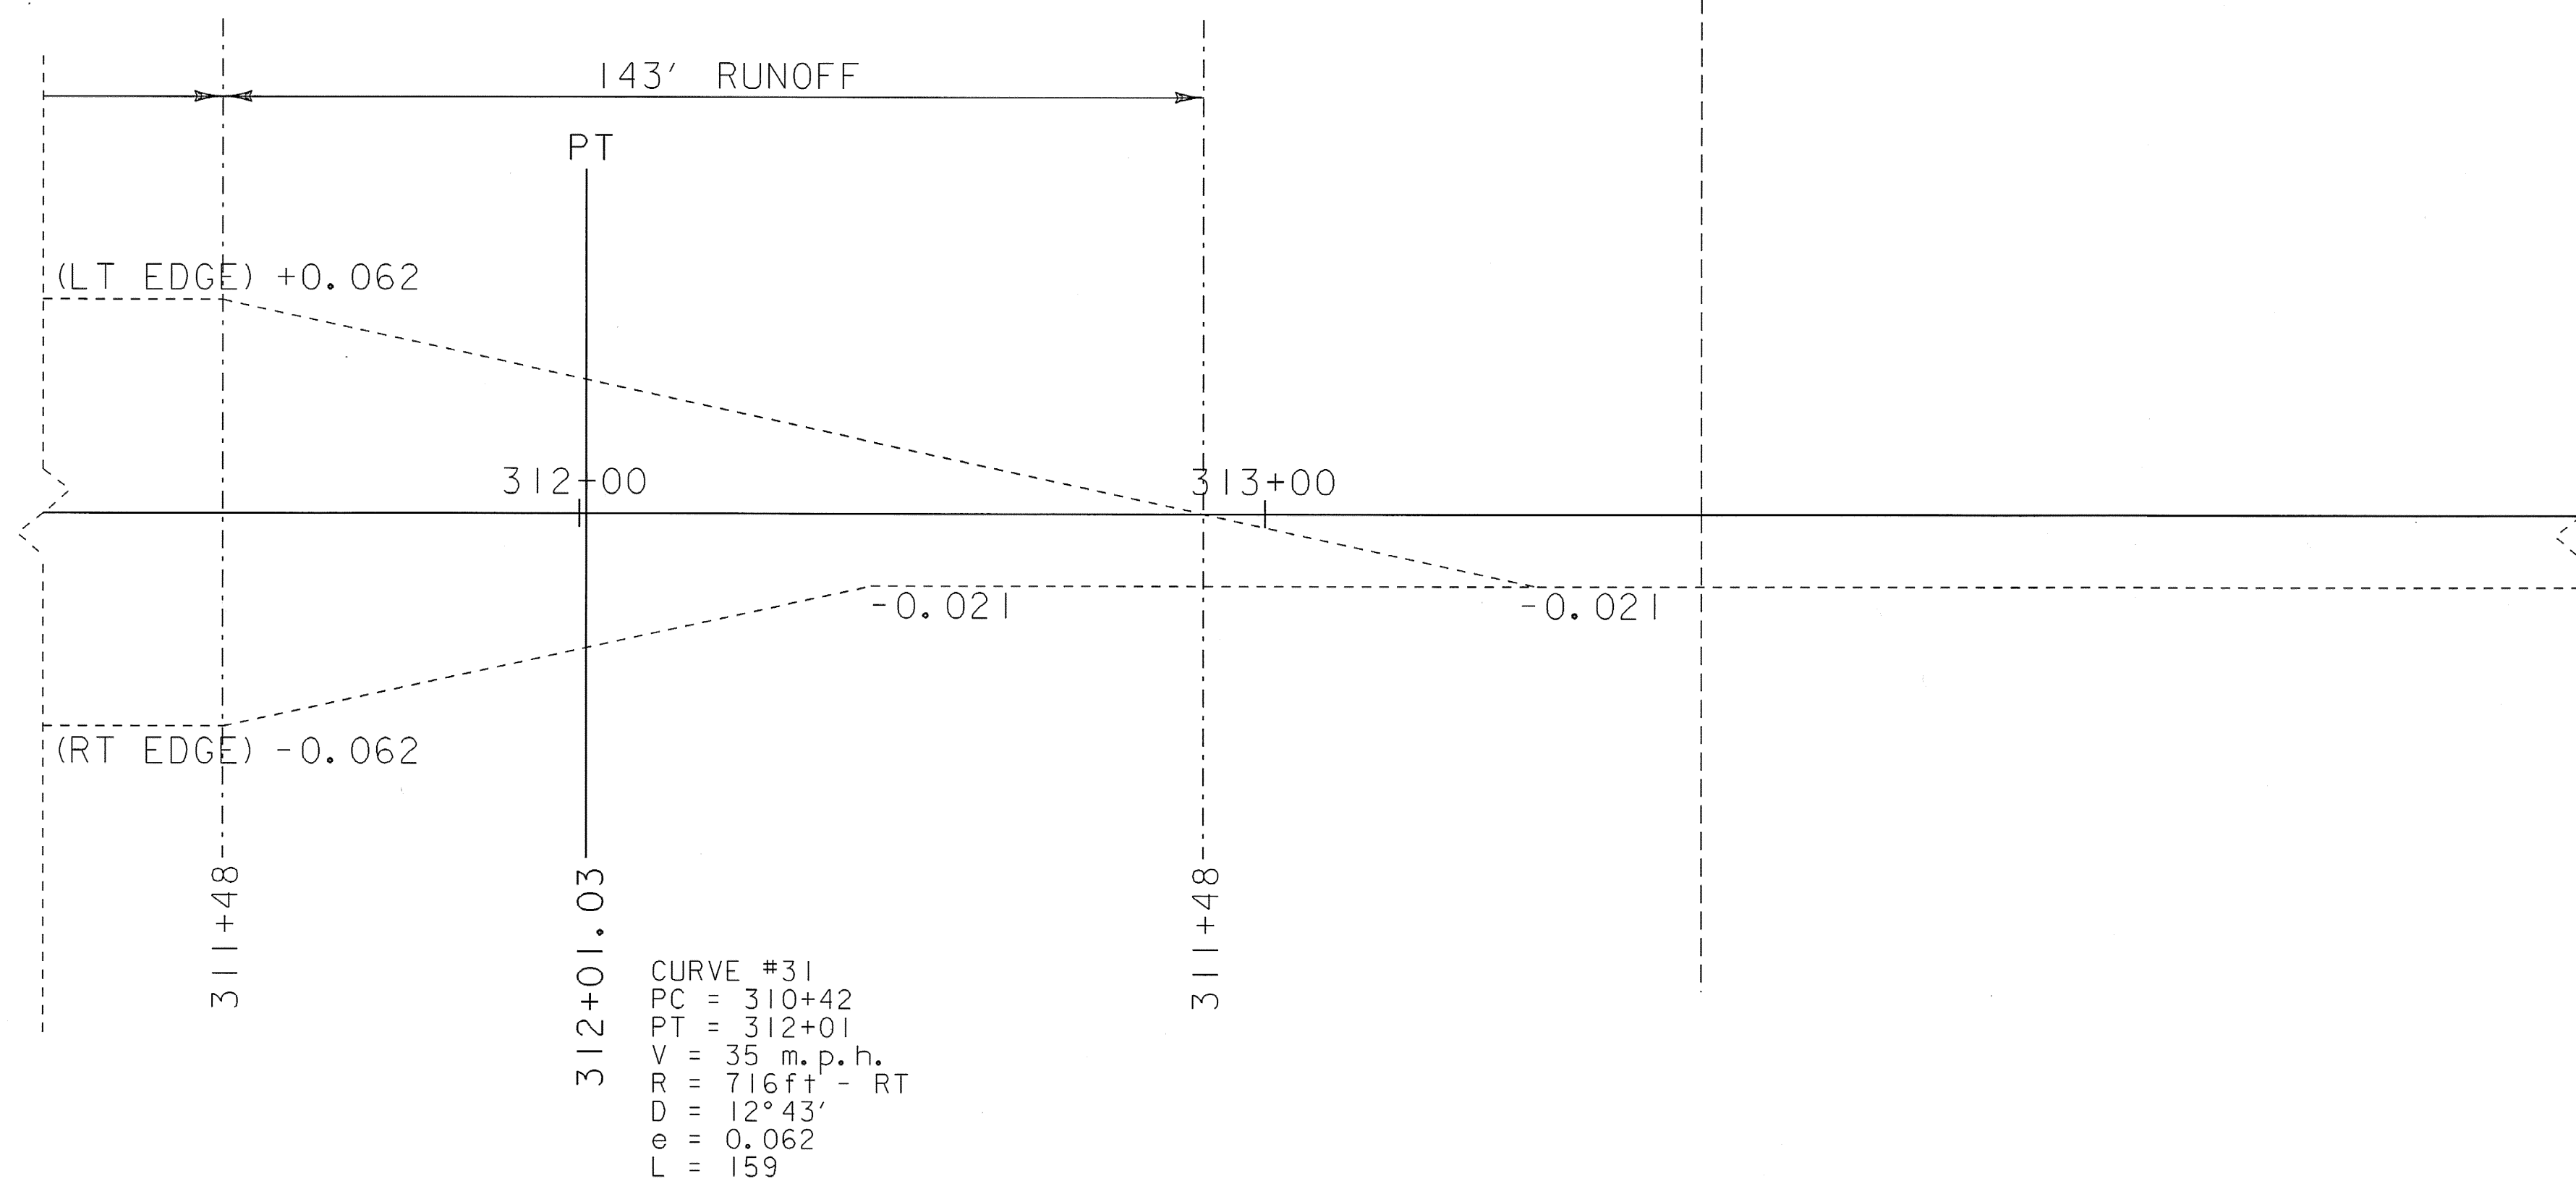

PROJECT NAME: SPRINGFIELD	PLOT DATE: 30-DEC-2008
PROJECT NUMBER: STP 0136(1)	DRAWN BY: B. KIPP
FILE NAME: Bank.dgn	CHECKED BY: N. PAPPAS
PROJECT LEADER: K. UPMAL	SHEET 60 OF 68
DESIGNED BY: B. KIPP	
BANKING DIAGRAM 13	