

Portland Cement Concrete  
Sidewalk - 125 mm  
Sta 1+066.250 - 1+100.000 RT


Vertical Granite Curb  
Sta 1+066.300 - 1+070.500 RT  
Sta 1+072.100 - 1+100.000 RT

Construct Crosswalk Ramp  
(2) Sta 1+071.500 RT +/-  
(Crosswalk to be Located at Church Walk)


Detectable Warning Surface  
Sta 1+168.000 - 1+170.000 RT  
Sta 1+172.000 - 1+174.000 RT  
Sta 1+095.000 - 1+097.000 RT

ALIGNMENT CURVE DATA

VT 12 Curve #1  
Delta = 4° 00' 11.2" RT  
Radius = 400.000  
Tangent = 13.979  
Length = 27.947  
External = 0.244

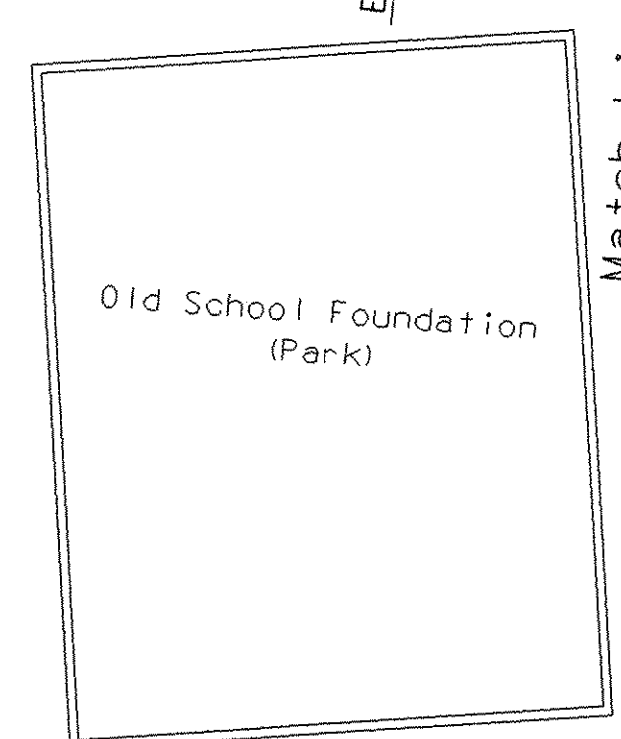

LAYOUT NO. 1

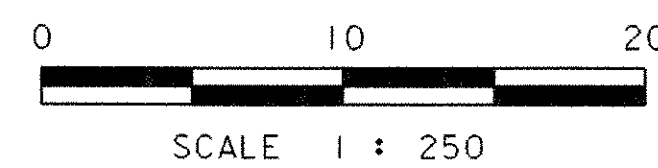

<b>DATUM</b>	
VERTICAL	NAVD 88
HORIZONTAL	NAD 83/92

PROJECT: <b>BETHEL</b>	PROJECT NO. : BRF0241 (33) C/2
DESIGN FILE NAME: 02c180/structures/s02c180bdr.dgn	PLOT DATE: 14-APR-2005
IPARM FILE NAME: sci801a1.i	SURVEY DATE: 10/99
SURVEYED BY: ORVIS	DRAWN BY: K. HIGGINS
SQUAD LEADER: C. P. WILLIAMS	SHEET: 10 OF 130
LAYOUT NO. 1	