


Profile Along VT. Route 12

NOTES:


GRADES SHOWN TO THE NEAREST HUNDREDTH ARE EXISTING GROUND ALONG ϕ .

GRADES SHOWN TO THE NEAREST THOUSANDTH ARE FINISH GRADE ALONG ϕ .

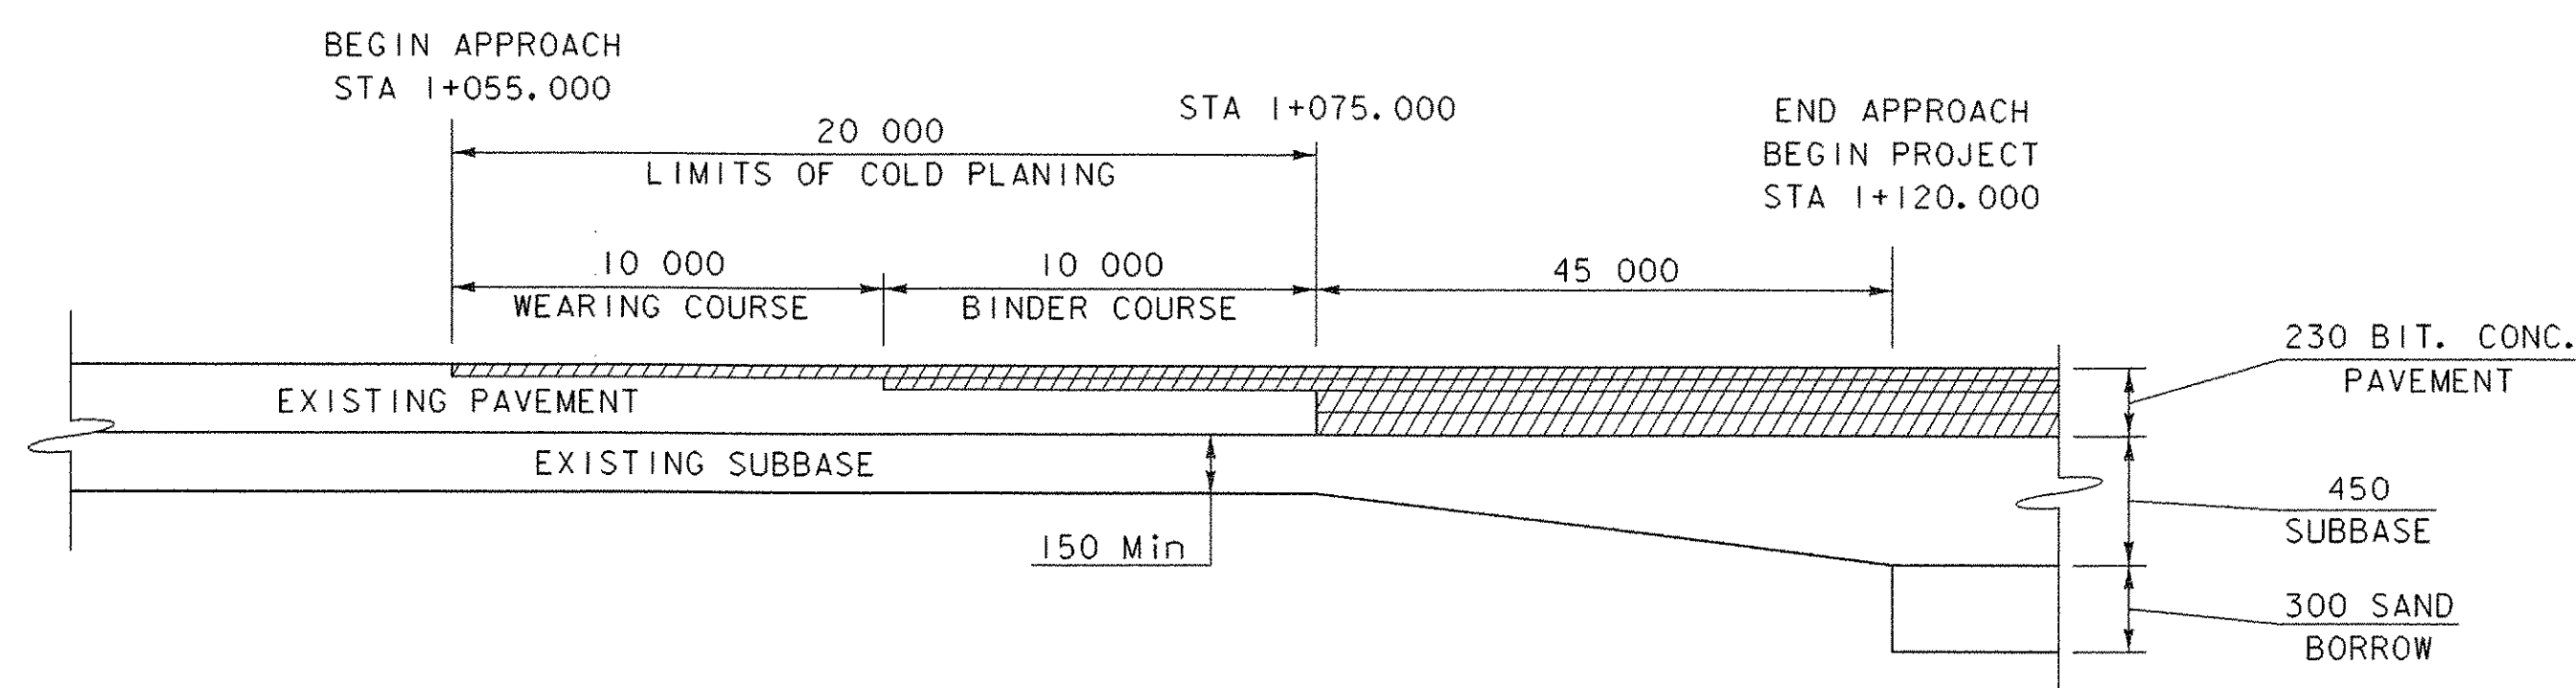

SUBBASE TAPER AT BEGIN PROJECT

NTS

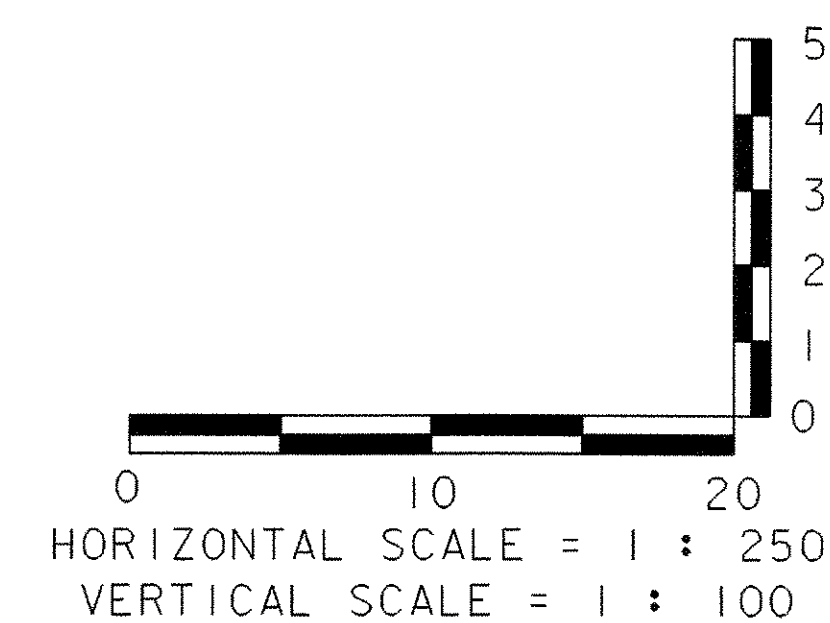

DATUM	
VERTICAL	NAVD 88
HORIZONTAL	NAD 83/92

PROJECT: BETHEL	PROJECT NO. : BRF0241 (33) C/2
DESIGN FILE NAME: 02c180/structures/s02c180pro.dgn	PLOT DATE: 14-APR-2005
IPARM FILE NAME: scl80prot.i	SURVEY DATE: 10/99
SURVEYED BY: ORVIS	DRAWN BY: K. HIGGINS
SQUAD LEADER: C. P. WILLIAMS	SHEET: 12 OF 130
PROFILE VT ROUTE 12	