



NOTES:
 GRADES SHOWN TO THE NEAREST HUNDREDTH ARE EXISTING GROUND ALONG \bar{C} .
 GRADES SHOWN TO THE NEAREST THOUSANDTH ARE FINISH GRADE ALONG \bar{C} .

Profile Along VT. Route 12

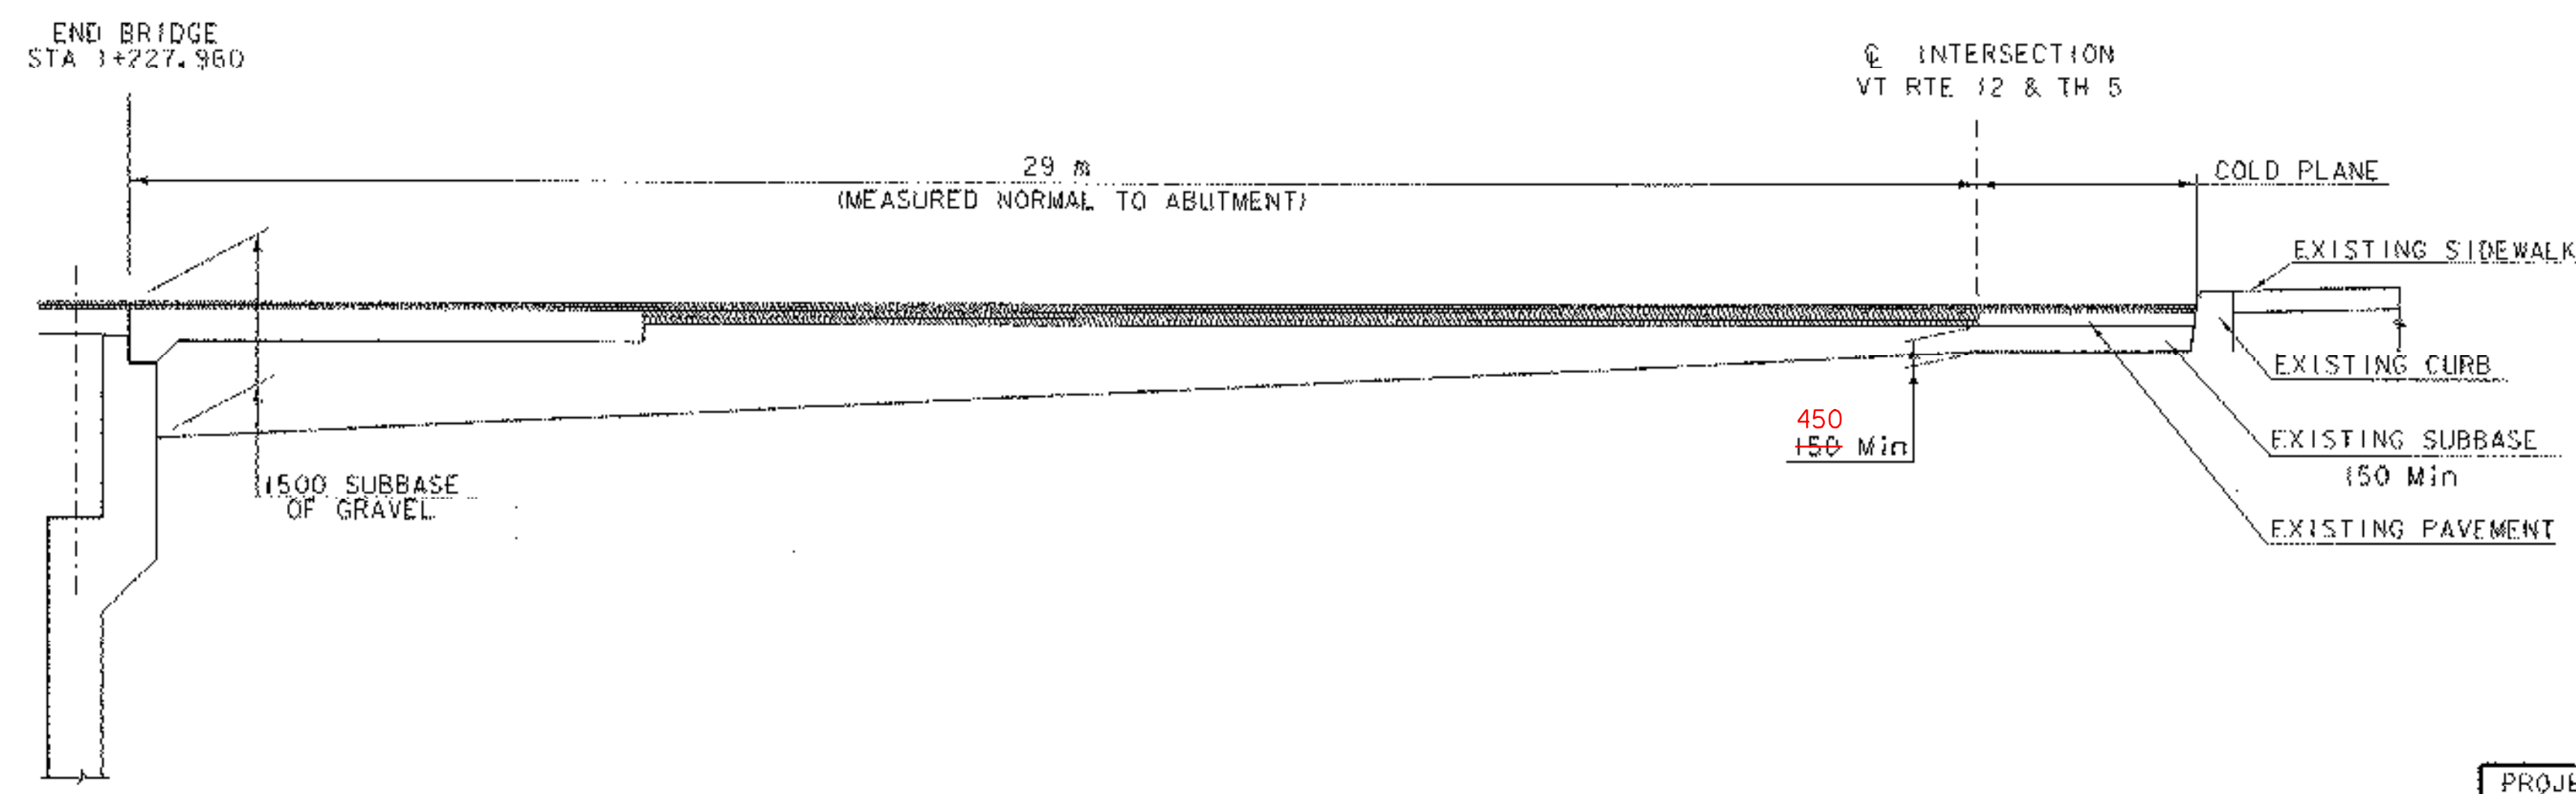

SUBBASE TAPER AT END BRIDGE

NTS

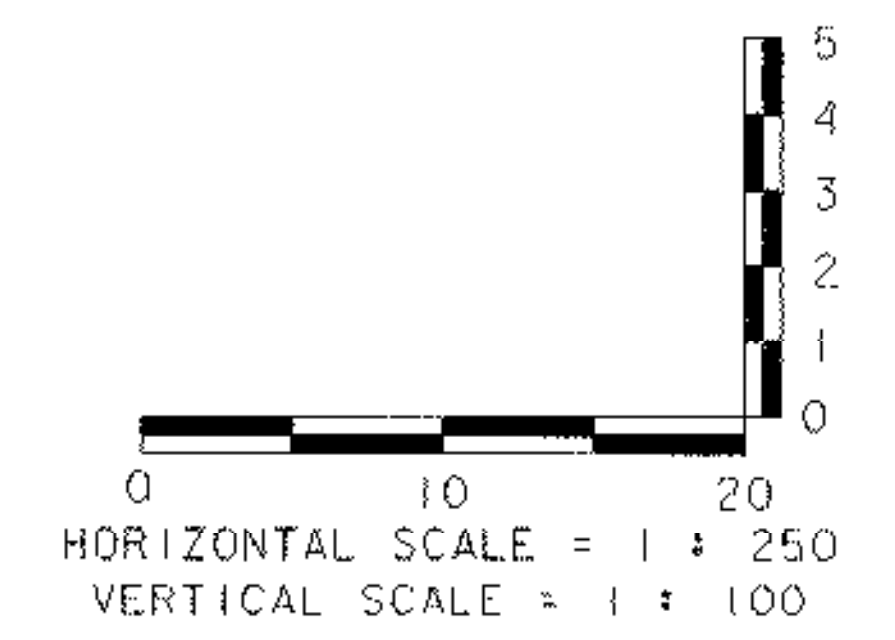

DATUM	
VERTICAL	NAVD 88
HORIZONTAL	NAD 83/92

PROJECT: BETHEL	PROJECT NO. : BRF0241 (33) C/2
DESIGN FILE NAME: 02c180/structures/s02c180pro.dgn	PLOT DATE: 14-APR-2005
PARAM FILE NAME: sc180pro2.i	SURVEY DATE: 10/99
SURVEYED BY: ORVIS	DRAWN BY: K. HIGGINS
SQUAD LEADER: C. P. WILLIAMS	SHEET: 13 OF 130
PROFILE VT ROUTE 12 (SHEET 2)	