



**PLAN VIEW**

SCALE 1 : 250

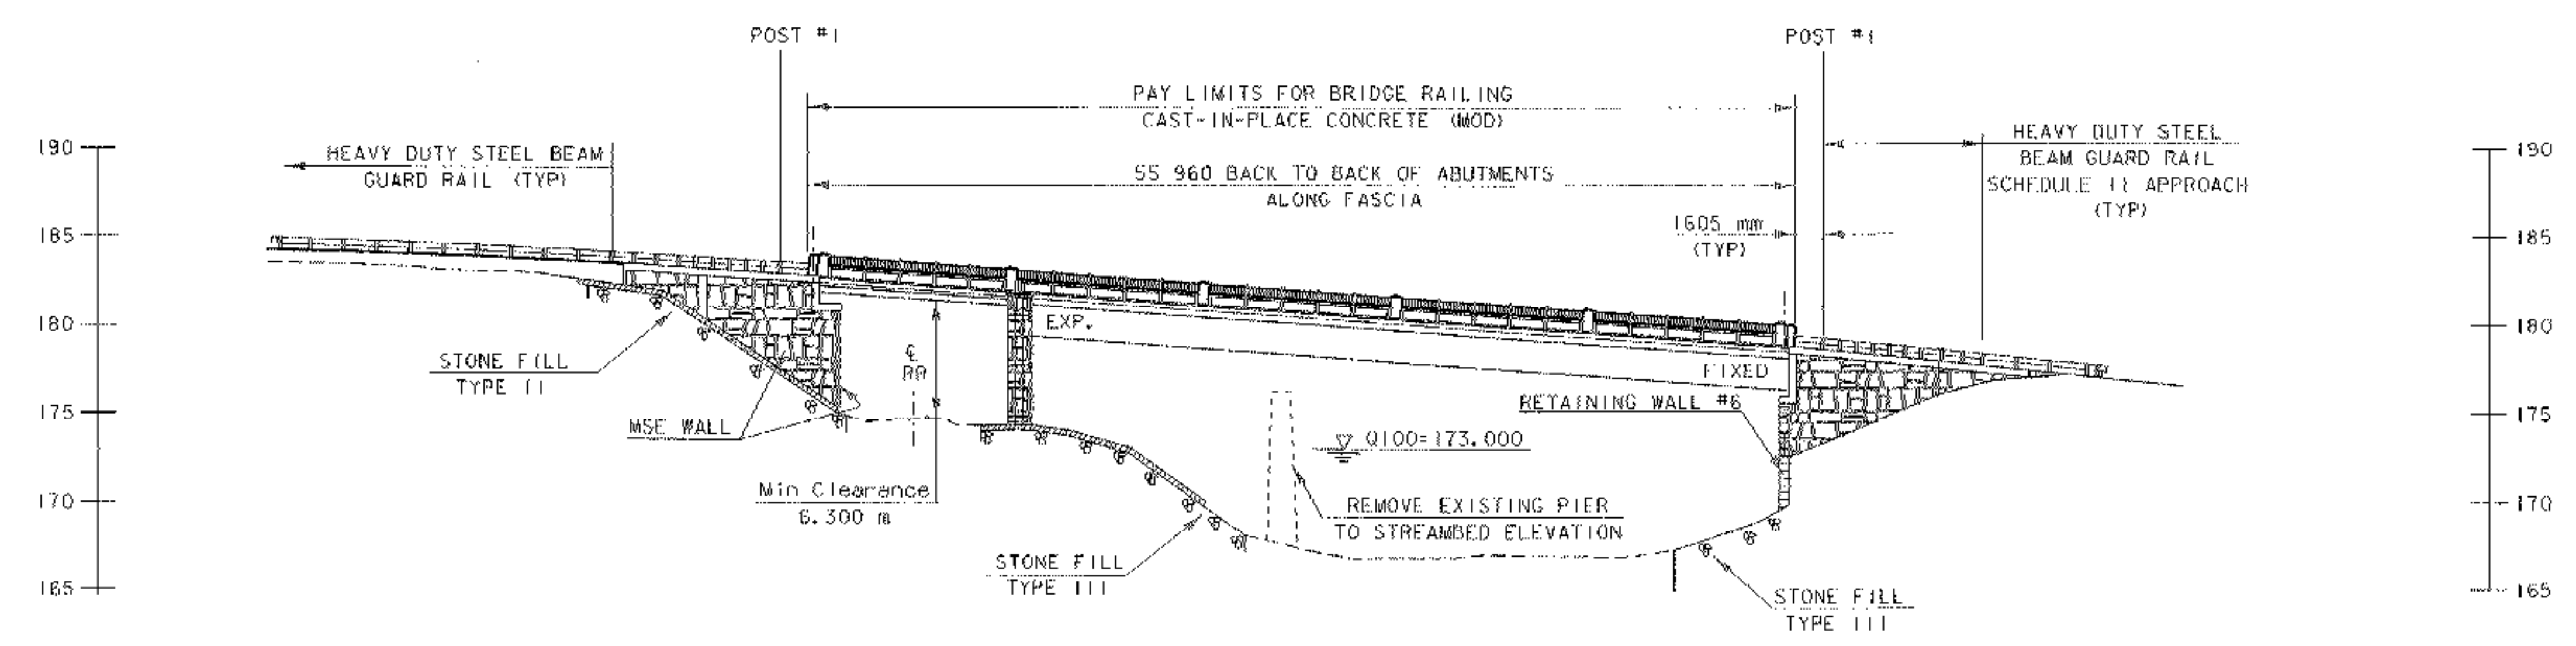

**ELEVATION AT FASCIA**

SCALE 1 : 250

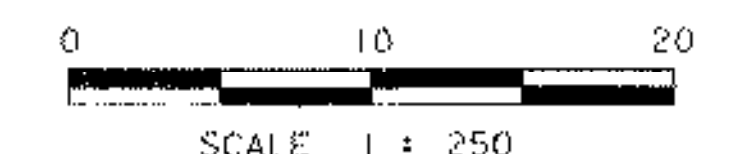

SCALE 1 : 250

DATUM	
VERTICAL	NAVD88
HORIZONTAL	NAD83 (92)

PROJECT: <b>BETHEL</b>	PROJECT NO. 1 <b>BRF0241 (33) C/2</b>
DESIGN FILE NAME: 02c180/Structures/s02c180pe.dgn	PLOT DATE: 15-APR-2005
IPARM FILE NAME: sc180pe.i	SURVEY DATE: 10/99
SURVEYED BY: ORVIS	DRAWN BY: T. ANDERSON
SQUAD LEADER: C.P. WILLIAMS	SHEET: 29 OF 130
PLAN & ELEVATION	