


EXPANSION JOINT @ PIER

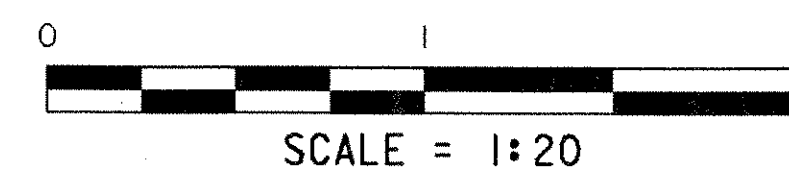

NOTE: SEE SHEET 46 FOR SECTIONS A-A, B-B & C-C

PROJECT: BETHEL	PROJECT NO.: BRF0241 (33) C/2
DESIGN FILE NAME: 02c180/structure/s02c180expjoint.dgn	PLOT DATE: 15-APR-2005
IPARM FILE NAME: expjoint2.i	DRAWN BY: M. GAGULIC
DESIGNED BY: M. GAGULIC	CHECKED BY: K. M. HIGGINS
SQUAD LEADER: C. P. WILLIAMS	SHEET: 45 OF 130
EXPANSION JOINT PLAN	