



PLAN VIEW
ABUTMENT #1 BACKWALL

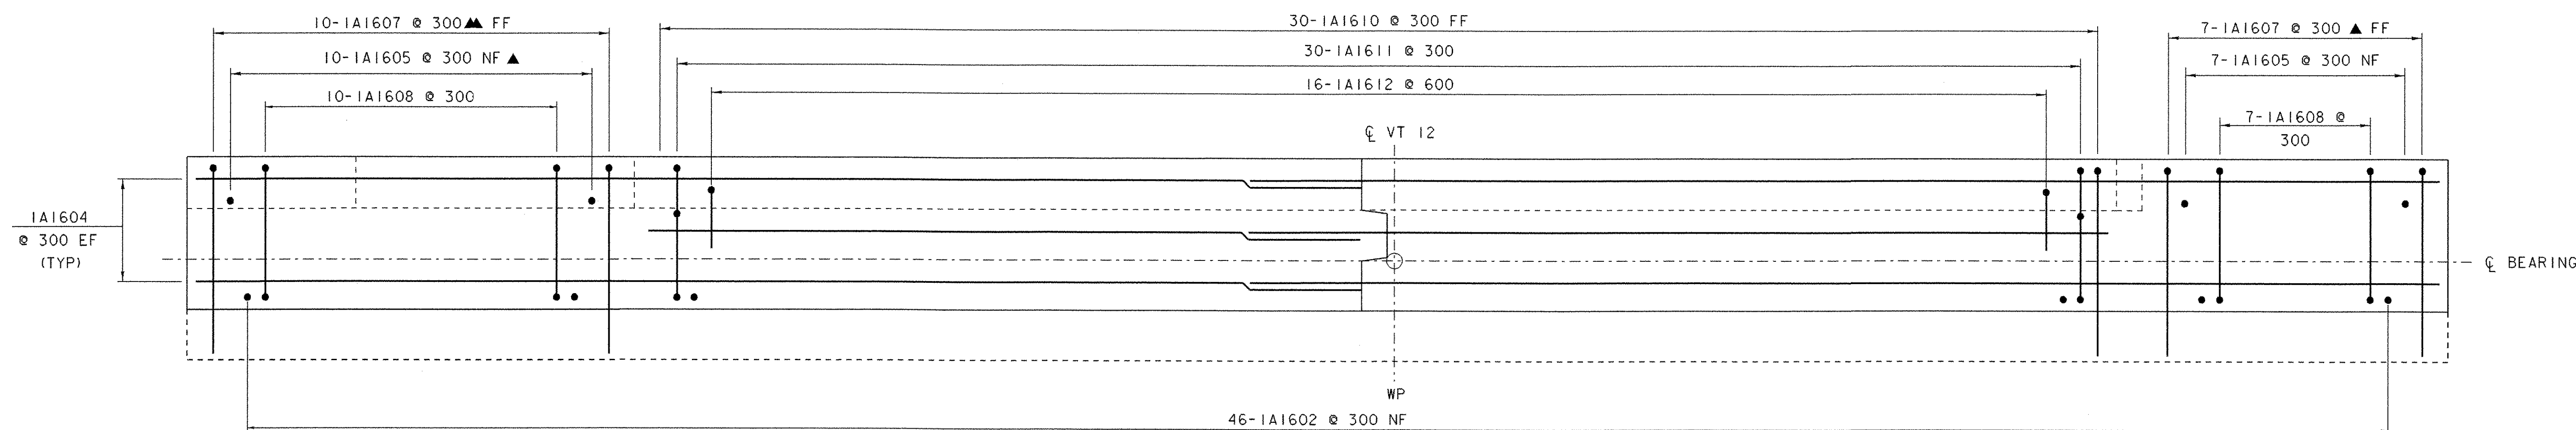

PLAN VIEW
ABUTMENT #1 STEM

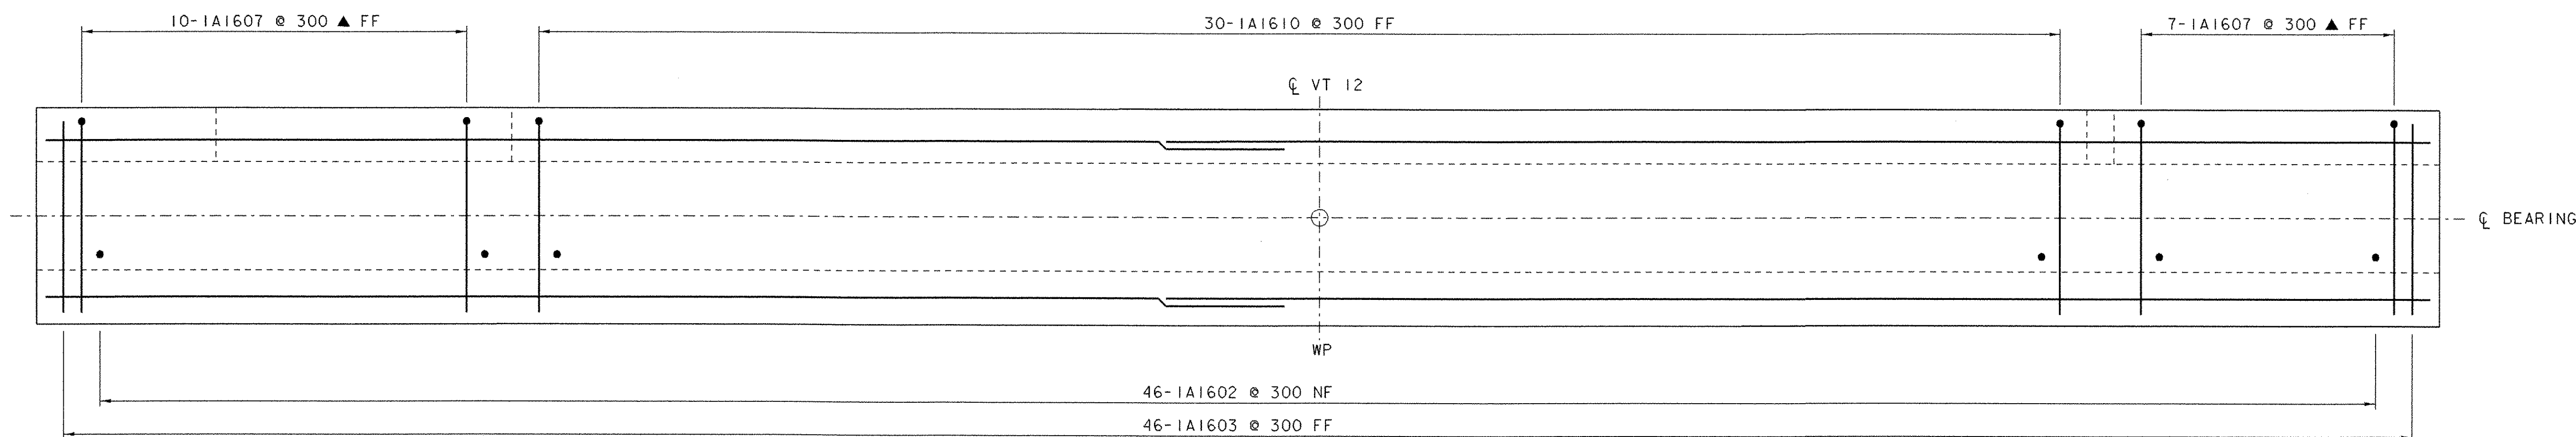


PLAN VIEW
ABUTMENT #1 FOOTING

NOTE:

- NF = NEAR FACE
- FF = FAR FACE
- EF = EACH FACE
- ▲ = CUT TO FIT IN FIELD

80 CLR. UNLESS OTHERWISE SPECIFIED ON THE PLANS.

ALL LAPS 660 UNLESS OTHERWISE SPECIFIED ON PLANS.

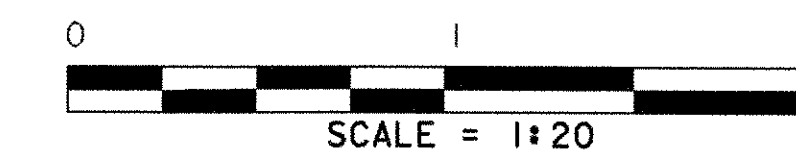

PROJECT: BETHEL	PROJECT NO.: BRF0241 (33) C/2
DESIGN FILE NAME: s02c180/structure/s02c180abut1.dgn	PLOT DATE: 15-APR-2005
IPARM FILE NAME: s02c180abldet.i	DRAWN BY: M. GAGULIC
DESIGNED BY: M. GAGULIC	CHECKED BY: K.M. HIGGINS
SQUAD LEADER: C.P. WILLIAMS	
ABUTMENT #1 REINFORCING DETAILS	SHEET: 50 OF 130