



ABUTMENT #2 BACKWALL
ELEVATION VIEW

SCALE = 1:40

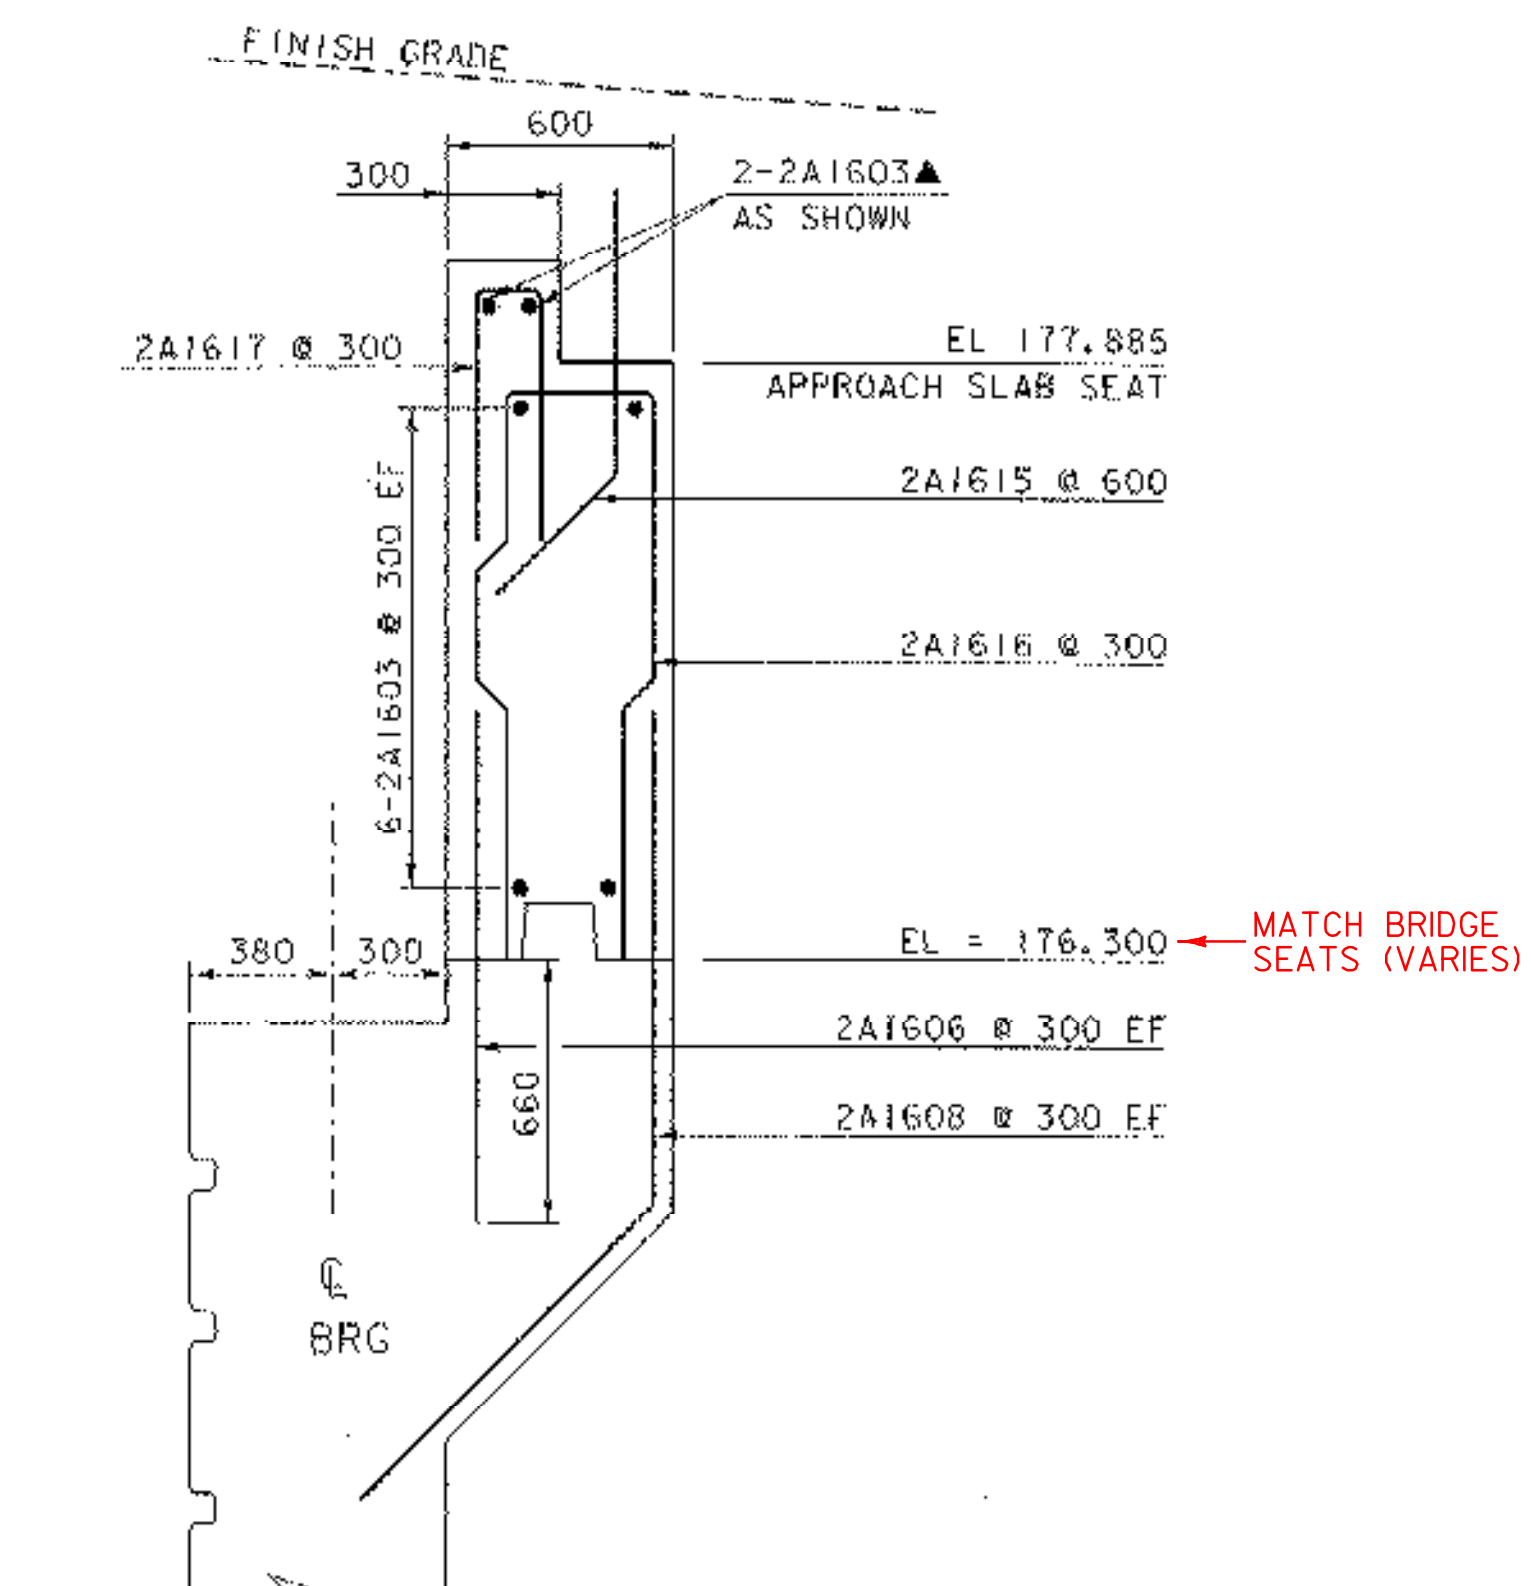

ABUTMENT #2 BACKWALL
TYPICAL DETAIL

SCALE = 1:20

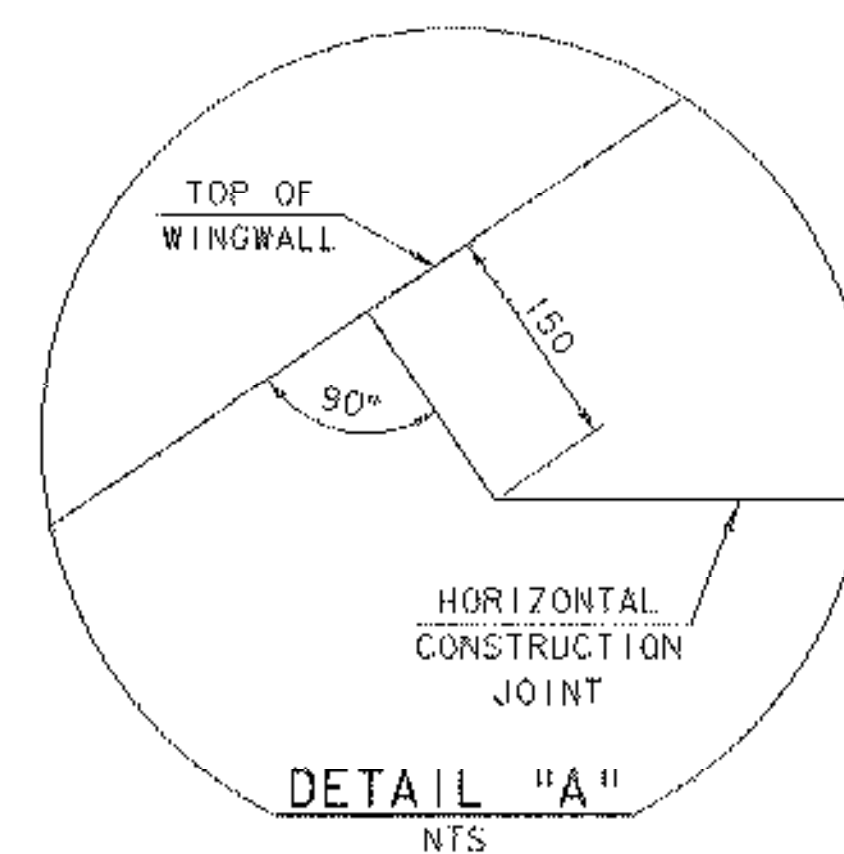

NOTES:

- NF = NEAR FACE
- FF = FAR FACE
- EF = EACH FACE
- ▲ = CUT TO FIT IN FIELD

80mm CLEAR UNLESS OTHERWISE SPECIFIED ON PLANS

ALL LAPS ARE 660mm UNLESS OTHERWISE SPECIFIED ON PLANS

PROJECT: BETHEL	PROJECT NO. # BRF0241 (33) C/2
DESIGN FILE NAME: s02c180/structures/s02c180abut2.dgn	PLOT DATE: 15-APR-2005
IPARM FILE NAME: s02c180abut2bw.i	DESIGNED BY: E.L. RUSTAY
DESIGNED BY: E.L. RUSTAY	DRAWN BY: E.L. RUSTAY
SQUAD LEADER: C.P. WILLIAMS	CHECKED BY: K.M. HIGGINS
ABUTMENT #2 BACKWALL DETAILS	SHEET: 56 OF 130