

SEE BACKWALL DETAILS ON SHEET 56

CONST. JOINT  
EL 176.300

CONST. JOINT  
EL 172.600


EL 169.750

**NOTES:**


- NF = NEAR FACE
- FF = FAR FACE
- EF = EACH FACE
- ▲ = CUT TO FIT IN FIELD

80mm CLEAR UNLESS OTHERWISE SPECIFIED ON PLANS

ALL LAPS ARE 660mm UNLESS OTHERWISE SPECIFIED ON PLANS

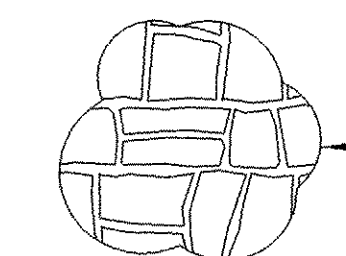

RUSTIC ASHLAR CUSTOM  
ROCK #11003 OR EQUIVALENT  
FORM LINERS AS SPECIFIED  
CONTINUE 150mm BELOW  
GROUND LEVEL

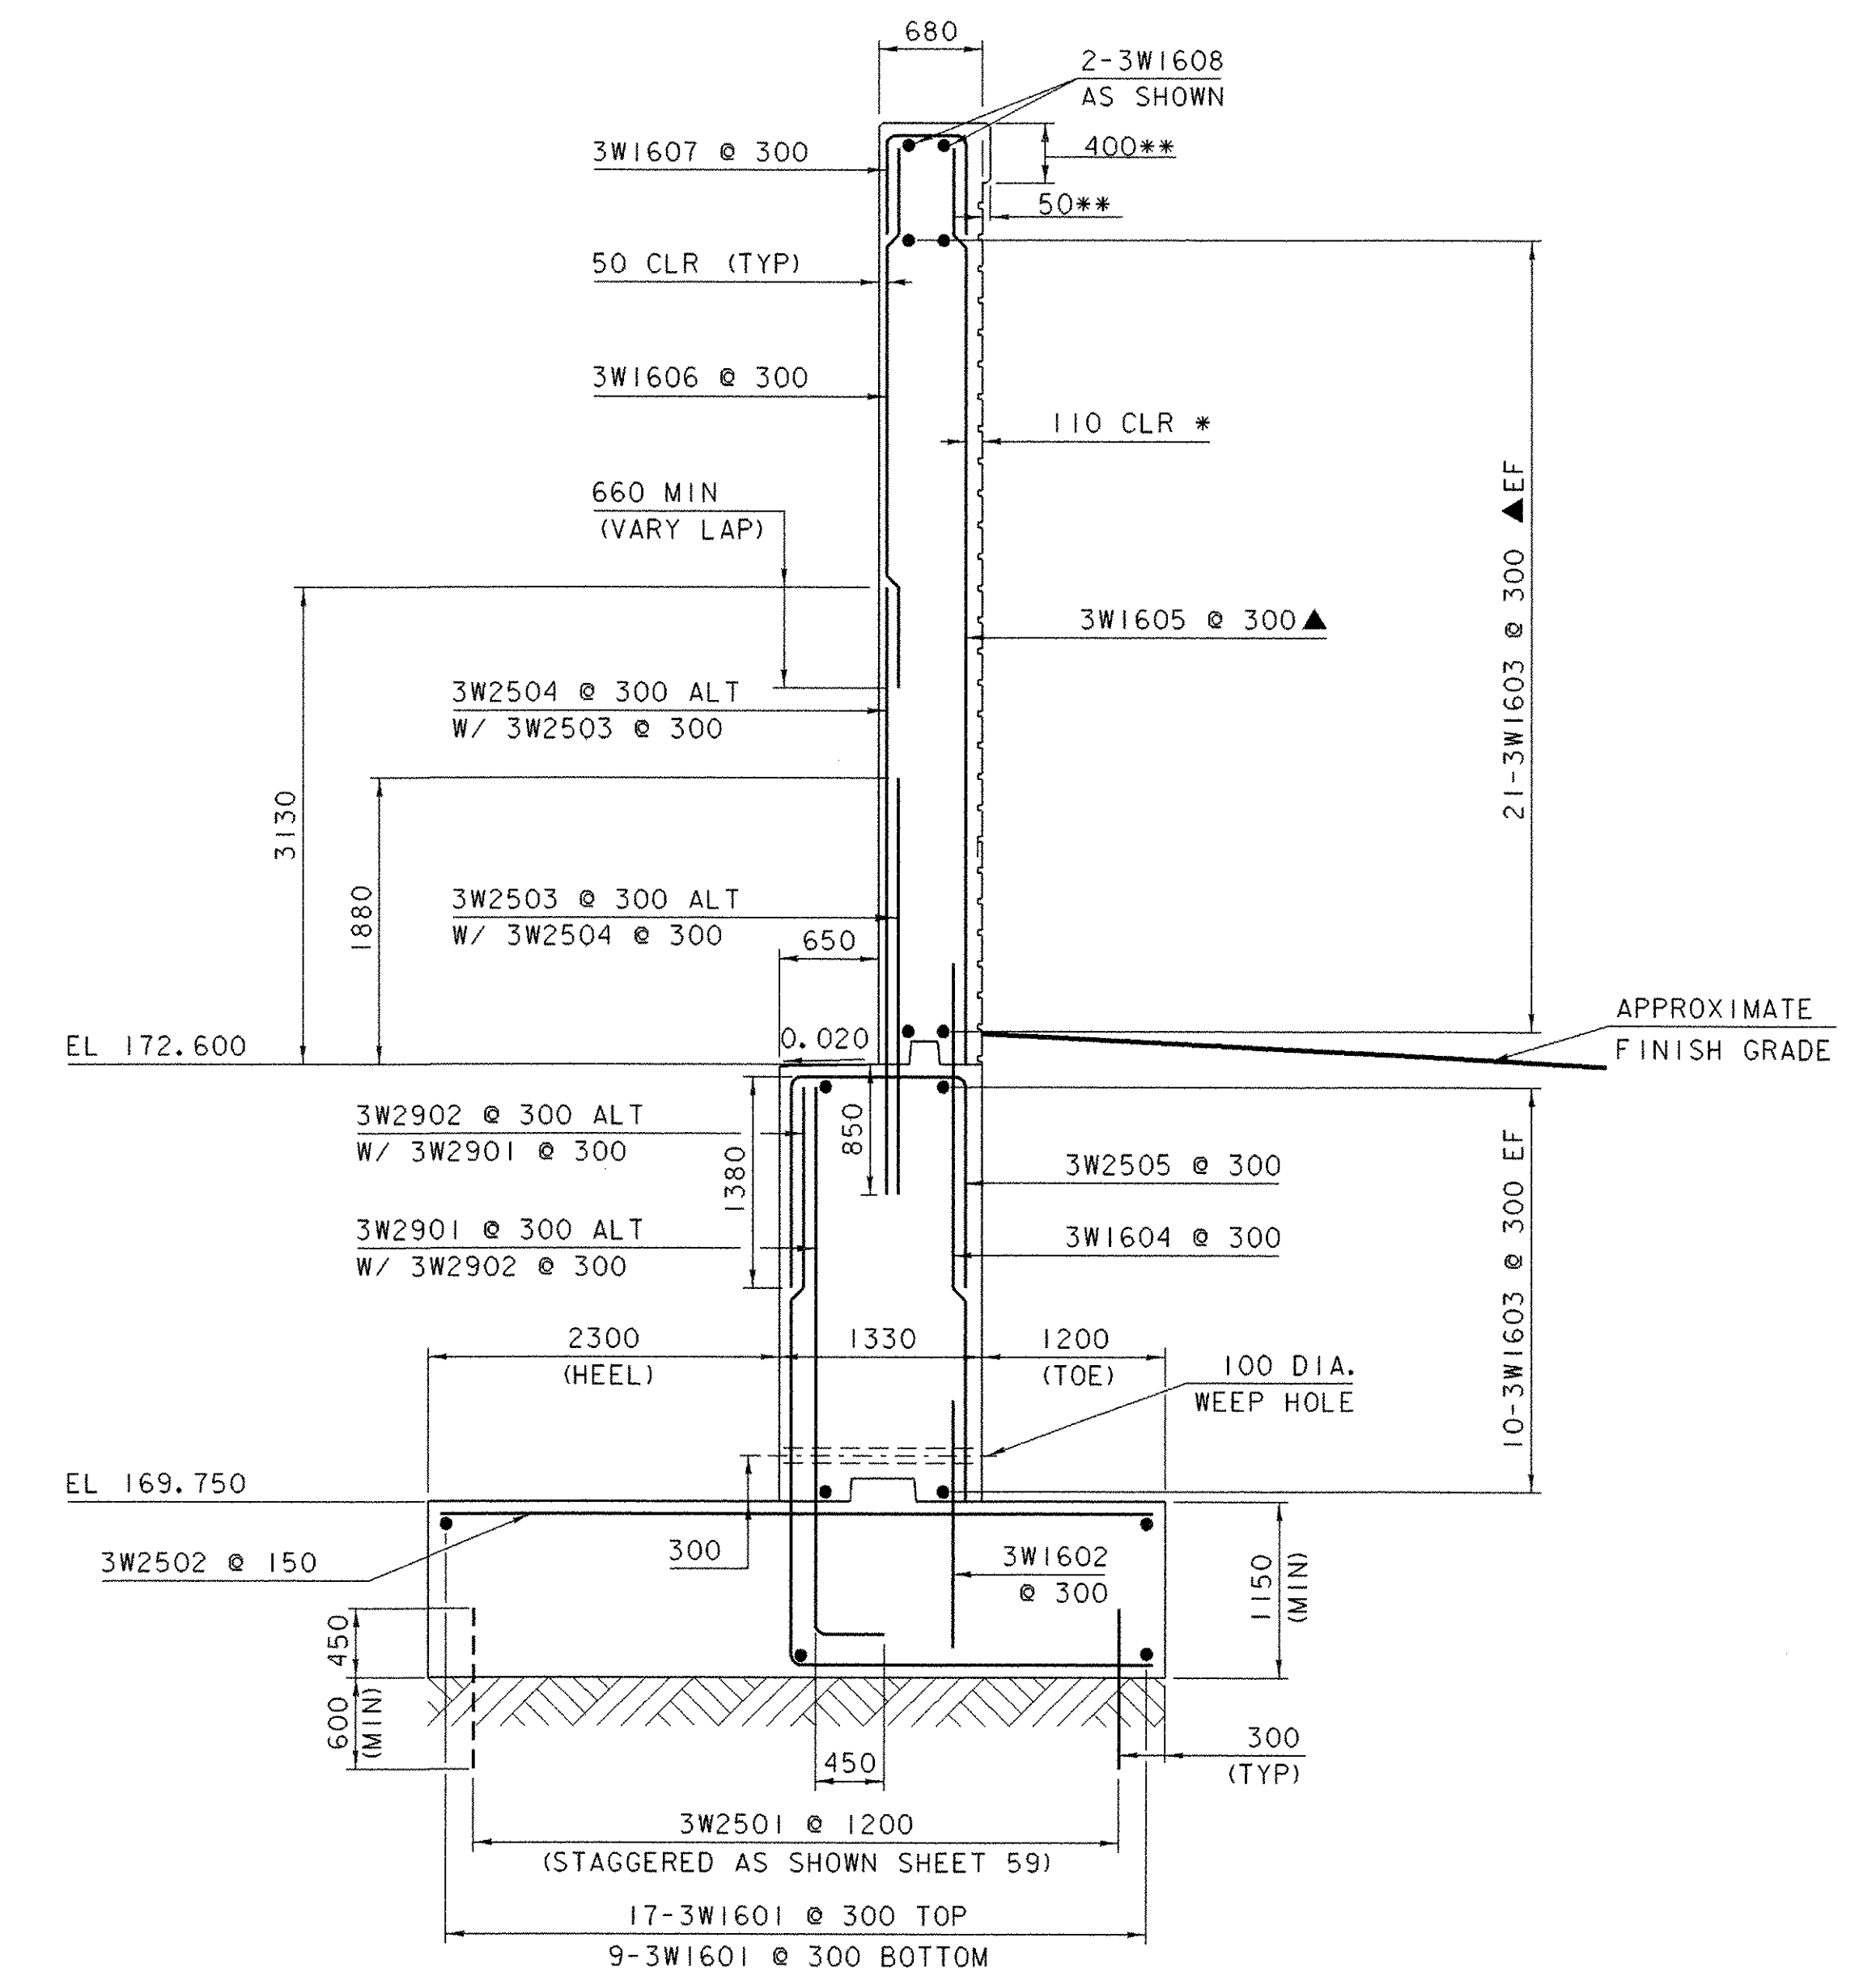


APPROXIMATE FINISH GRADE

\* CLEAR COVER INCLUDES 30 mm FOR MAXIMUM FORM LINER RELIEF

\*\* END FORM LINERS AND CONSTRUCT COPING (NOT SHOWN IN PLAN VIEW)

**WINGWALL #3  
TYPICAL SECTION  
SCALE 1:40**

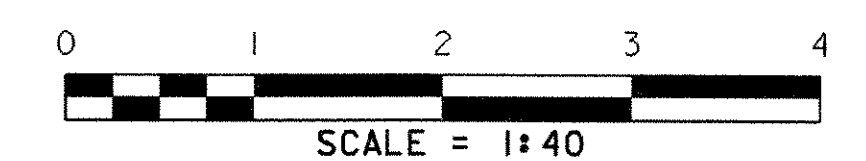

PROJECT: <b>BETHEL</b>	PROJECT NO.: <b>BRF0241 (33) C/2</b>
DESIGN FILE NAME: 02c180/structures/s02c180abut2.dgn	PLOT DATE: 15-APR-2005
IPARM FILE NAME: s02c180ww3.i	DRAWN BY: E.L.RUSTAY
DESIGNED BY: E.L.RUSTAY	CHECKED BY: K.M.HIGGINS
SQUAD LEADER: C.P.WILLIAMS	WINGWALL #3 DETAILS
	SHEET: 57 OF 130