


JOB: 1012.011-KUBARKY-DETAIL VT BRIDGE  
SHEET NO. SK 1 OF  
CALCULATED BY: RHC DATE: 8/5/05  
CHECKED BY: JMB DATE: 8/23/05  
SCALE: 1:100

*Change of Design  
Pilled shafts were  
used for the pier*

PIER PLAN  
SCALE= 1:100

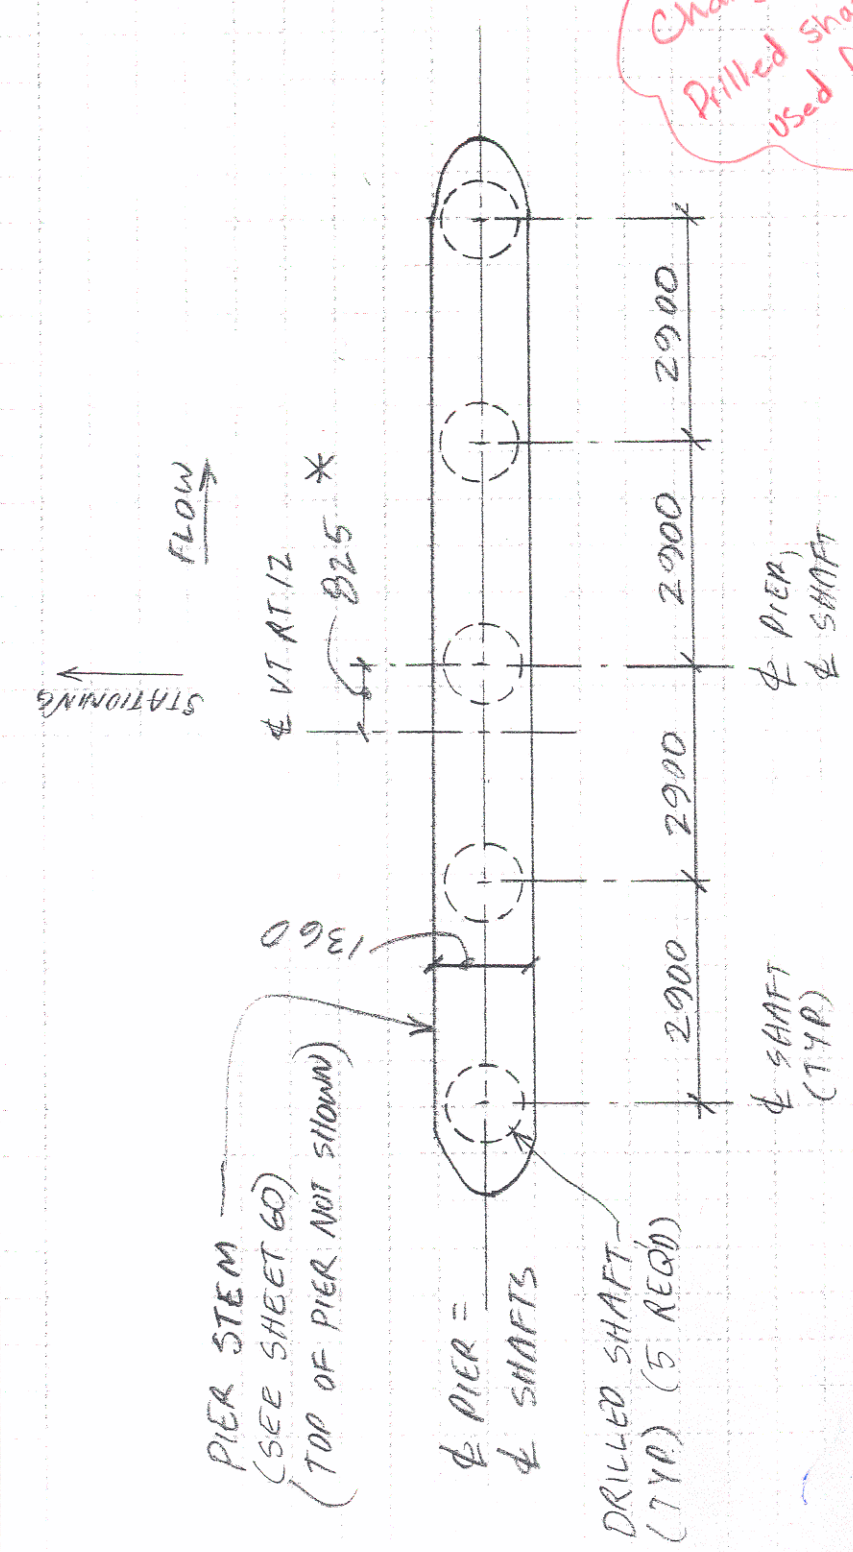

\* NOTE: A DIMENSION ERROR SEEMS TO EXIST ON THE CONTRACT DRAWING SHEET 60 REGARDING PIER LENGTH AND LOCATION OF VT RT12 CENTRALINE. KUBARKY AND VART SHALL VERIFY THAT 825 DIMENSION SHOWN ABOVE IS CORRECT, AND SHALL CONSULT WITH B&L IF IT IS NOT.