



RETAINING WALL #5
PLAN VIEW

SCALE = 1:20

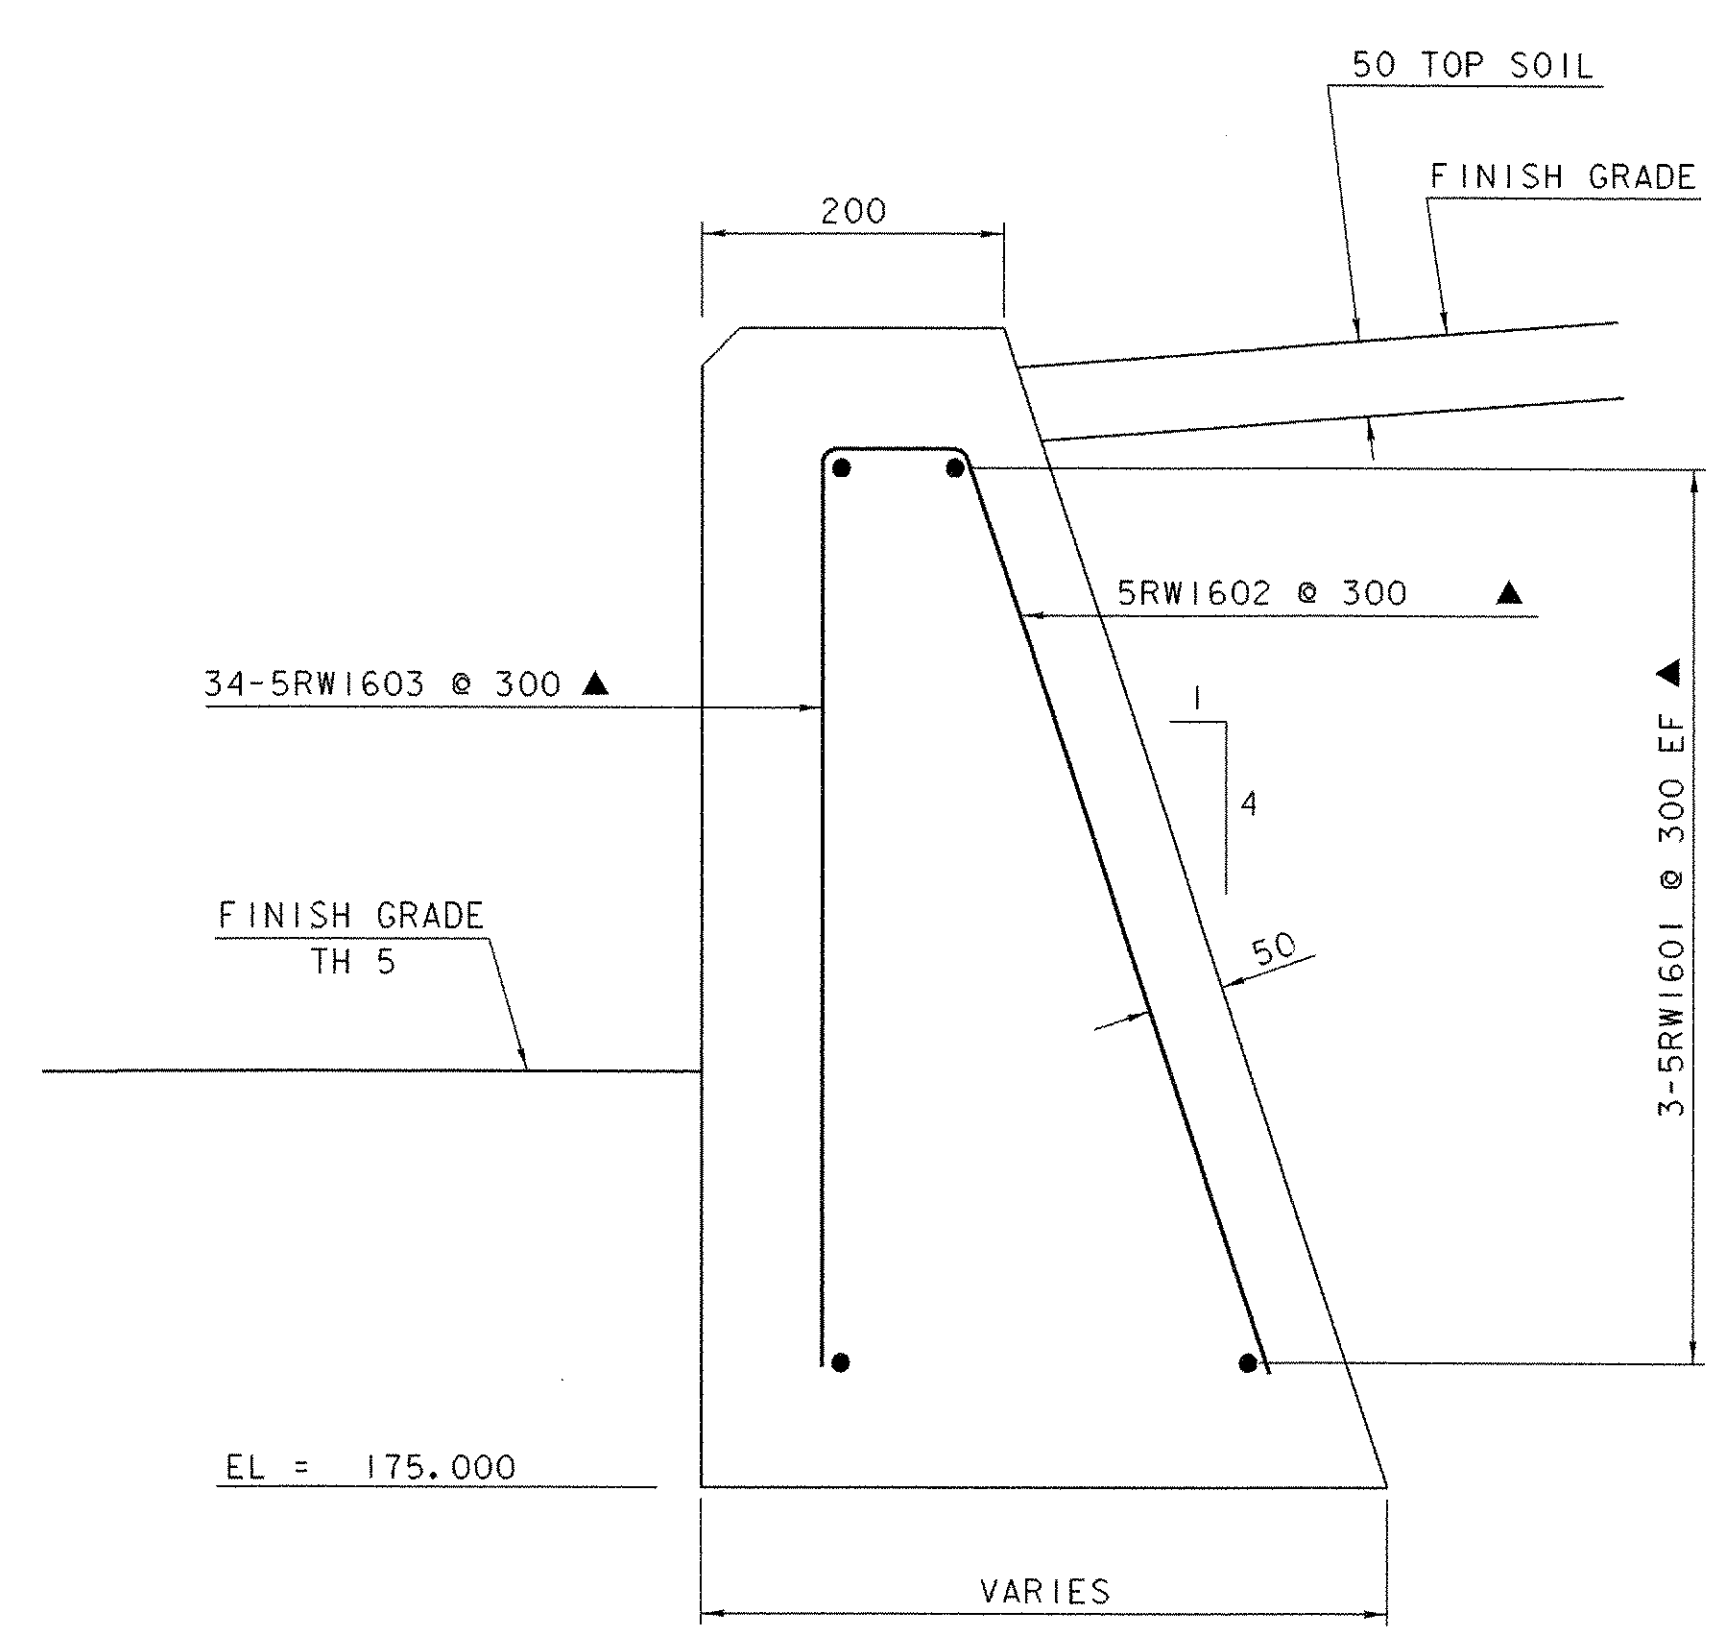

TYPICAL SECTION
RETAINING WALL #5

SCALE = 1:5

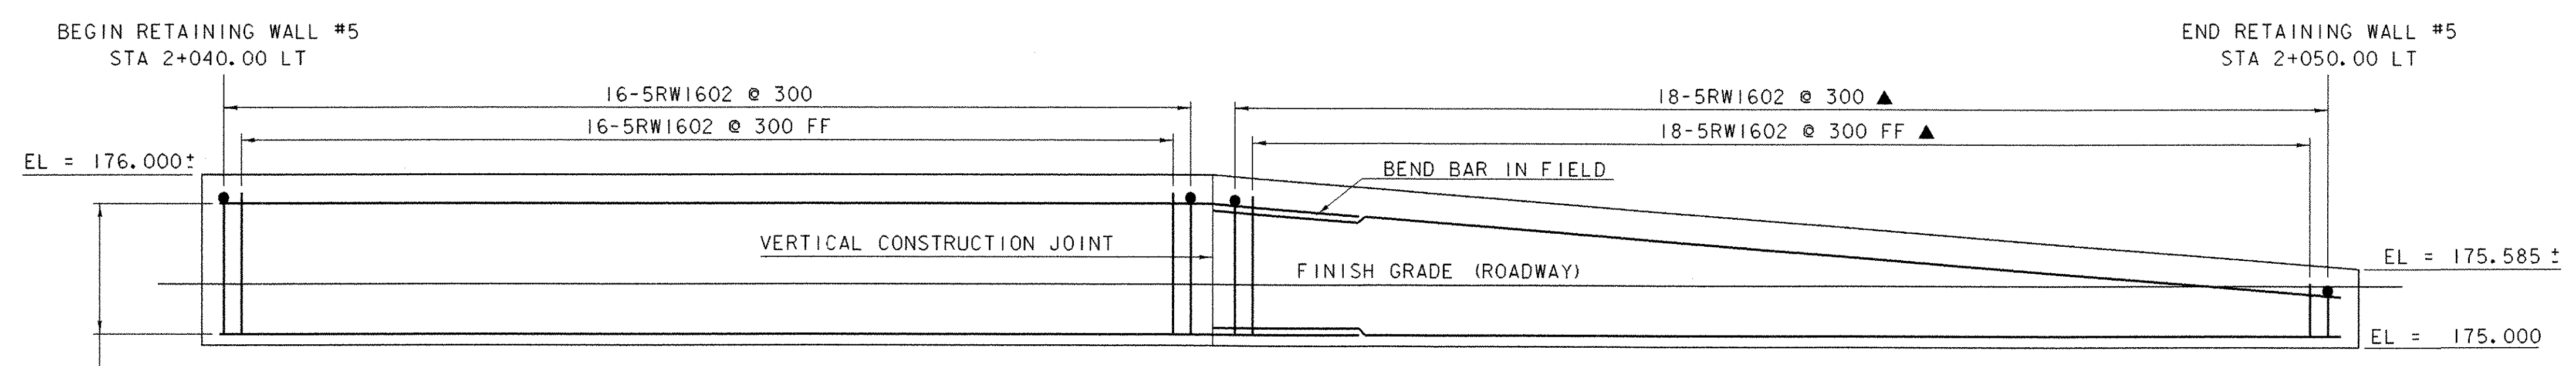

NOTE:
TOP OF WALL ELEVATION TO MATCH EXISTING WALL

RETAINING WALL #5
ELEVATION VIEW

SCALE = 1:20

NOTES:

- NF = NEAR FACE
- FF = FAR FACE
- EF = EACH FACE
- ▲ = CUT TO FIT IN FIELD
- 80mm CLEAR UNLESS OTHERWISE SPECIFIED ON PLANS
- ALL LAPS ARE 660mm UNLESS OTHERWISE SPECIFIED ON PLANS
- DIMENSIONS AND ELEVATIONS SHALL BE VERIFIED IN THE FIELD BY THE RESIDENT ENGINEER.
- THE EXISTING WALL SHALL BE REMOVED UNDER THE ITEM 529.15 "REMOVAL OF STRUCTURE (STA 2+040.000-2+050.000 LT) "

PROJECT: BETHEL	PROJECT NO.: BRF0241 (33) C/2
DESIGN FILE NAME: 02c180/structures/s02c180retainwall.dgn	
IPARM FILE NAME: s02c180retwall15.i	
DESIGNED BY: E.L.RUSTAY	DRAWN BY: E.L.RUSTAY
SQUAD LEADER: C.P.WILLIAMS	CHECKED BY: K.M.HIGGINS
RETAINING WALL #5 DETAILS	SHEET: 72 OF 130